

NOV 07 1994

LAND CORNER RECORDATION CERTIFICATE  
Filing Requirement of Act 74, Mich. P.A. 1970


For corners in

Chippewa  
(County)

Located In:

Corner Code #

- |                                       |   |     |   |    |      |
|---------------------------------------|---|-----|---|----|------|
| 1. Public Land Survey                 | T | 44N | R | 1W | L-13 |
|                                       | T |     | R |    |      |
|                                       | T |     | R |    |      |
|                                       | T |     | R |    |      |
| 2. Property Controlling in Section    | S |     | T | R  |      |
|                                       | S |     | T | R  |      |
| 3. Miscellaneous Property in Sec.     | S |     | T | R  |      |
|                                       | S |     | T | R  |      |
| 4. Lot No. _____, Recorded Plat _____ |   |     |   |    |      |
| 5. Private Claims _____               |   |     |   |    |      |

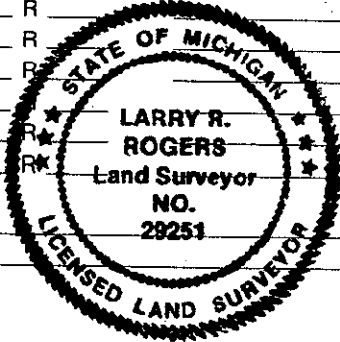

\$ 7.00 LAND CORNER  
\$ 2.00 MSSR  
26 OCT 94 9:46 A.M. RECEIPT# 860  
RECEIVED FOR RECORD  
CHIPPEWA COUNTY - STATE OF MICHIGAN  
SHARON H. KENNEDY, REGISTER OF DEEDS  
Register of Deeds Stamp & File Number

|    | A  | B  | C  | D  | E  | F  | G | H | I | J | K | L | M |
|----|----|----|----|----|----|----|---|---|---|---|---|---|---|
| 2  | 6  | 5  |    | 4  | 3  | 2  | 1 |   |   |   |   |   |   |
| 3  |    |    |    |    |    |    |   |   |   |   |   |   |   |
| 4  | 7  | 8  | 9  | 10 | 11 | 12 |   |   |   |   |   |   |   |
| 5  |    |    |    |    |    |    |   |   |   |   |   |   |   |
| 6  | 18 | 17 | 16 | 15 | 14 | 13 |   |   |   |   |   |   |   |
| 7  |    |    |    |    |    |    |   |   |   |   |   |   |   |
| 8  | 19 | 20 | 21 | 22 | 23 | 24 |   |   |   |   |   |   |   |
| 9  |    |    |    |    |    |    |   |   |   |   |   |   |   |
| 10 | 30 | 29 | 28 | 27 | 26 | 25 |   |   |   |   |   |   |   |
| 11 |    |    |    |    |    |    |   |   |   |   |   |   |   |
| 12 | 31 | 32 | 33 | 34 | 35 | 36 |   |   |   |   |   |   |   |
| 13 |    |    |    |    |    |    |   |   |   |   |   |   |   |

I, Larry R. Rogers in a field survey on May 10, 19 94 do hereby certify that under requirements of P.A. 74, Michigan P.A. of 1970, the corner points mentioned in lines 1 and 2 above were in conformance with regulations and rules therefore as required in the current manual of survey instructions of the United States Department of the Interior, Bureau of Land Management or by a decree of a Court of Law and/or that the corner points mentioned in lines 3, 4 and 5 above were in conformance with the rules of the Michigan Board of Land Surveyors or by a Decree of a Court of Law; established, re-established, monumented, re-monumented, recovered, found as expressed below:

**NOTE: Not more than 4 corners, all in the same town and range, may be recorded on this certificate.**

A. Description of original monument and accessories and/or subsequent restoration:

(L-13) South 1/4 Corner of Section 36, (Standard Corner) T44N-R1W


Corner previously recorded in 1986 by W. L. Karr, P.S. 27450 in Liber 6, Page 300 of the Chippewa County Corner Records as a 1" iron pipe in a monument box with the following witnesses:

- |                            |       |        |
|----------------------------|-------|--------|
| Southeast Corner of Garage | N24°E | 87.50' |
| Northeast Corner of Garage | S27°E | 36.24' |
| Northwest Corner of Garage | S11°W | 33.00' |
| Utility Pole               | N15°W | 32.00' |
| Iron in Monument Box       | S80°W | 8.54'  |

B. Description of corner evidence found and/or method applied in restoring or reestablishing corner:

(L-13) This corner is being perpetuated as part of the Chippewa County Remonumentation Program.

Found pipe in monument box as witnessed by Karr. Corner position matches other monumentation in "Windy Knoll Subdivision". Accepted corner position as found.

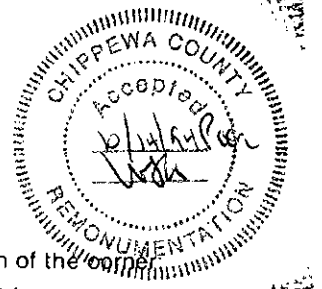

C. Description of monument for corner and accessories established to perpetuate locating the position of the corner:  
(L-13) Corner is a 1" iron pipe in monument box in centerline of Townline Road.

Witnesses:

- |                              |       |                           |
|------------------------------|-------|---------------------------|
| Southeast Corner of Garage   | N24°E | 87.50' (existing witness) |
| Northeast Corner of Garage   | S13°E | 73.45' (new witness)      |
| Utility Pole with #22428 Tag | S19°W | 28.95' (new witness)      |
| Utility Pole (S436/10)       | N15°W | 32.00' (existing witness) |
| Iron in Monument Box         | S80°W | 8.54'                     |

Signed by [Signature] Date 24 OCT 1994

Surveyor's Michigan License No. 29251

NOTE: Bearings are compass bearings corrected for declination.  
Distances are to a nail in side of witness objects unless noted.