

LAND CORNER RECORDATION CERTIFICATE
Filing Requirement of Act 74, Mich. P.A. 1970

For corners in

Chippewa

(County)

Located In:

Corner Code #

- 1. Public Land Survey { T 44N R 1W M-12
- 1/4 Cor. Common to: T 44N R 1E A-12
- Section Corner T 44N R 1W M-11
- Common to: T 44N R 1E A-11
- 2. Property Controlling S _____ T _____ R _____
- in Section S _____ T _____ R _____
- 3. Miscellaneous S _____ T _____ R _____
- Property in Sec. S _____ T _____ R _____

RECEIVED FOR RECORD
CHIPPEWA COUNTY
STATE OF MICHIGAN

94 JUL 22 AM 11:07

J. Roger Madole

REGISTER OF DEEDS
Register of Deeds Stamp & File Number

- 4. Lot No. _____, Recorded Plat _____
- 5. Private Claims _____

I, Keith R. Waters, in a field survey on OCTOBER 5, 19 93, do hereby certify that under requirements of P.A. 74, Michigan P.A. of 1970, the corner points mentioned in lines 1 and 2 above were in conformance with regulations and rules therefore as required in the current manual of survey instructions of the United States Department of the Interior, Bureau of Land Management or by a decree of a Court of Law and/or that the corner points mentioned in lines 3, 4 and 5 above were in conformance with the rules of the Michigan Board of Land Surveyors or by a Decree of a Court of Law; established, re-established, monumented, re-monumented, recovered, found as expressed below:

A	B	C	D	E	F	G	H	I	J	K	L	M
2	6	5	4	3	2	1						
3												
4	7	8	9	10	11	12						
5												
6	18	17	16	15	14	13						
7												
8	19	20	21	22	23	24						
9												
10	30	29	28	27	26	25						
11												
12	31	32	33	34	35	36						
13												

NOTE: Not more than 4 corners, all in the same town and range, may be recorded on this certificate.

A. Description of original monument and accessories and/or subsequent restoration:

(M-12) From 1986 LCRC, Liber 6, Page 301: 1/2" x 18" iron & cap #27450 on M-129 centerline N89E 74.30' Top R/W Marker, N89W 74.20' Top R/W Marker, N68W 68.82' 12" Spruce
1992: Neil Hill reset 1/2" iron with cap #27447 (L.7, P.360). N89E 74.24' PK Top Con R/W Mkr, N89W 74.16' PK Top Conc R/W Mkr, N68W 68.97' MDOT Tag 12" Spruce, N85E 77.64' MDOT Tag Power Pole, N85W 75.39' MDOT Tag Power Pole, North 2629.47' Section Corner
(M-11) 1979 LCRC, Liber 4, Page 269: Found monument box with iron as called for in MDOT right-of-way maps. N73E 79.40' Conc. R/W Marker, S75W 78.80' Conc. R/W mkr.
1992: Neil Hill found 3/4" iron and accepted (L.7, P.360). N73E 79.37' PK Top Conc. R/W Mkr., S75W 78.74' Conc. R/W Mkr (Broken), S50E 100.93' Power Pole, N70W 79.86' Cor FE Post, N25E 185.32' Power Pole

B. Description of corner evidence found and/or method applied in restoring or reestablishing corner:


(M-12) Found corner and all accessories as recorded in Liber 7, Page 360 of the Chippewa County Records. Accepted corner position as found.

(M-11) Found corner and all accessories as recorded in Liber 7, Page 360 of the Chippewa County Records. Accepted corner position as found.

SURVEY &
REMONUMENTATION

JUL 26 1994

COMMISSION

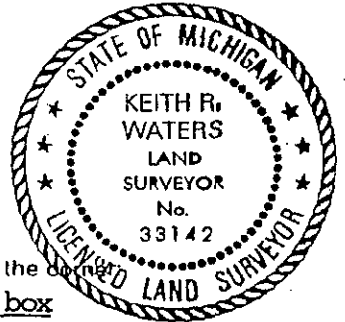

C. Description of monument for corner and accessories established to perpetuate locating the position of the corner

(M-12) 1/2" re-rod & cap #27447 in Easterly Side of Monument

(M-11) 3/4" rod in monument box

WITNESSES

WITNESSES

- N 89 E 74.24' PK Top Conc R/W Mkr
- N 89 W 74.16' PK Top Conc R/W Mkr
- N 68 W 68.97' MDOT Tag 12" Spruce
- N 85 E 77.64' MDOT Tag Power Pole
- N 85 W 75.39' MDOT Tag Power Pole
- North 2629.47' Section Corner

- N 73 E 79.37' PK Top Conc. R/W Mkr.
- S 75 W 78.74' Conc. R/W Mkr (Broken)
- S 50 E 100.93' Power Pole
- N 70 W 79.86' Cor FE Post
- N 25 E 185.32' Power Pole

Signed by Keith R. Waters

Date 7-22-94

Surveyor's Michigan License No. 33142

NOTE: Bearings are compass bearings corrected for declination.

Distances are to a nail in side of witness objects unless noted.