

MICHIGAN
DEPARTMENT OF CONSERVATION
FORESTRY DIVISION

LAND CORNER RECORD

T. 44 N.R. 1 W


Chippewa COUNTY

DESCRIPTION OF CORNER Section Corner common to Sections 10-11-14-15

CORNER MONUMENT 1" Pipe with 4" Brass Cap (buried)

DATE MONUMENT PLACED AND WITNESSED 5-16-62 with W. Lehman, District Forester

WITNESSES TO CORNER..... NBT's: 13" Red Pine (S 1/4 NBT) S 66° E 115 links

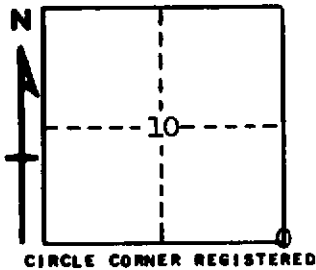

20" W. Pine (NBT) S 51° W 50 links

AND

DESCRIPTION IN DETAIL AS TO HOW CORNER WAS LOCATED AND IDENTIFIED OR RESTORED.

This corner was placed in Road Intersection and agrees with records of old fences to East.

No evidence of original corner.

Corner lies in Intersection of Roads N-E and W.

SURVEYOR'S SEAL

SIGNED Billy D. Buckler DATE 8-22-63
REGISTERED LAND SURVEYOR
Billy D. Buckler