

MICHIGAN
DEPARTMENT OF CONSERVATION
FORESTRY DIVISION

LAND CORNER RECORD

T. 44 N.R. 1 W


Chippewa COUNTY

DESCRIPTION OF CORNER Closing Corner for Sections 2-3 on North boundary of Township.

CORNER MONUMENT 1" Pipe with 4" Aluminum Cap

DATE MONUMENT PLACED AND WITNESSED 5-16-62

WITNESSES TO CORNER..... NBT's: 14" Red Oak (S 3 NBT) S 47° W 127 links

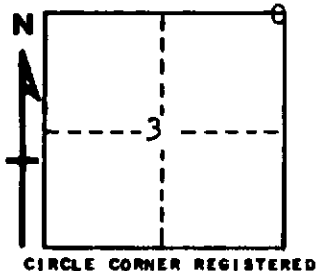

AND

DESCRIPTION IN DETAIL AS TO HOW CORNER WAS LOCATED AND IDENTIFIED OR RESTORED.

This corner was replaced at record distance from Section Corner 34-35, T 45 N, R 1 W.

Note: Section Corner 34-35, T 45 N, R 1 W lies 20 links West.

SURVEYOR'S SEAL

SIGNED Billy D. Buckler DATE 8-23-63
REGISTERED LAND SURVEYOR
Billy D. Buckler