

LAND CORNER RECORDATION CERTIFICATE
Filing Requirement of Act 74, Mich. P.A. 1970

For corners in
Chippewa

(County)

Located In:	Corner Code #
1. Public Land Survey	T ___ R ___
	T ___ R ___
	T ___ R ___
	T ___ R ___
2. Property Controlling in Section	S <u>14</u> T <u>44N</u> R <u>1W</u> 9
	S <u>14</u> T <u>44N</u> R <u>1W</u> 8
3. Miscellaneous Property in Sec.	S ___ T ___ R ___
	S ___ T ___ R ___

Register of Deeds Stamp & File Number

4. Lot No. _____, Recorded Plat _____
 5. Private Claims _____

8 Jun 25 2003
 9 Jul 08 2003

I, Stephan J. Szyszkoski, in a field survey on _____, 20__ do hereby state that under requirements of P.A. 74, Michigan P.A. of 1970, the corner points mentioned in lines 1 and 2 above were in conformance with regulations and rules therefore as required in the current manual of survey instructions of the United States Department of the Interior, Bureau of Land Management or by a decree of a Court of Law and /or that the corner points mentioned in lines 3, 4 and 5 above were in conformance with the rules of the Michigan Board of Land Surveyors or by a Decree of a Court of Law; established, re-established, monumented, recovered, found as expressed below:

NOTE: Not more than 2 corners, all in the same town and range, may be recorded on this certificate.


A	B	C	D	E	F	G	H	I	J	K	L	M
1												
2	6	5	4	3	2	1						
3												
4	7	8	9	10	11	12						
5												
6	18	17	16	15	14	13						
7												
8	19	20	21	22	23	24						
9												
10	30	29	28	27	26	25						
11												
12	31	32	33	34	35	36						
13												

A. Description of original monument and accessories and/or subsequent restoration:
 (9-Sec. 14) East 1/16 corner, Section 14. Not established in the original survey.
 (8-Sec. 14) West 1/16 corner, Section 14. Not established in the original survey.

B. Description of corner evidence found and/or method applied in restoring or reestablishing corner:
 (9-Sec. 16) Established the corner midway and on a straight line between Center of Section 1314.41' West and Quarter corner 1314.41' East. From the corner thus established, I found a 1"ID iron pipe with an iron fence post adjacent, placed by unknown persons, S87W 36.4' distant.
 (8-Sec. 14) Established the corner midway and on a straight line between Quarter corner 1311.41' West and Center of Section 1311.41' East.

C. Description of monument for corner and accessories established to perpetuate locating the position of the corner:

(9) Set 1"IDx36" I.pipe with 4" alum. MDNR cap. Blazed, scribed, and set measuring nails in: 5" Balsam N54W 2.3' "E1/16 BT" 14" Spruce S48E 8.0' do 14" Tamarack N85E 27.1' do 10" Spruce N30E 32.4' do Set cedar post adjacent. Bearings are magnetic. Distances are to nail with tag.	(8) Set 1"IDx36" I.pipe with 4" alum. MDNR cap. Blazed, scribed, and set measuring nails in: 12" Spruce S83E 10.75' "W1/16 BT" 5" Spruce N45E 7.95' do 12" Spruce N59W 9.4' do 6" Spruce S45W 13.15' do Set cedar post adjacent. Bearings are magnetic. Distances are to nail with tag.
--	--

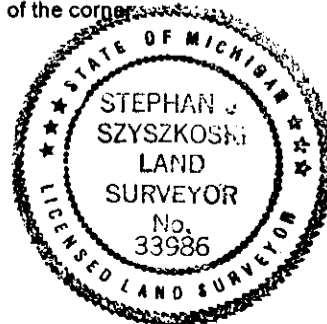

Signed by Stephan J. Szyszkoski
 Surveyor's Michigan License No. 33986

Date 7/29/03