

LAND CORNER RECORDATION CERTIFICATE
Filing Requirement of Act 74, Mich. P.A. 1970 as Amended

For corners in

<u>Chippewa</u> (County)	Located In:	Corner Code #
1. Public Land Survey	T ___ R ___	_____
	T ___ R ___	_____
	T ___ R ___	_____
2. Property Controlling in Section	S <u>29</u> T <u>44N</u> R <u>01W</u>	<u>D10</u>
3. Miscellaneous Property in Sec.	S ___ T ___ R ___	<u>16</u>
	S ___ T ___ R ___	_____

Register of Deeds Stamp & File
Number

4. Lot No. _____, Recorded Plat _____
 5. Private Claims

D10 Aug 01 2007
 16 Sep 26 2006

I, Stephan J. Szyszkoski, in a field survey on _____, 20__ do hereby state that under requirements of P.A. 74, Michigan P.A. of 1970, the corner points mentioned in lines 1 and 2 above were in conformance with regulations and rules therefore as required in the current manual of survey instructions of the United States Department of the Interior, Bureau of Land Management or by a decree of a Court of Law and /or that the corner points mentioned in lines 3, 4 and 5 above were in conformance with the rules of the Michigan Board of Land Surveyors or by a Decree of a Court of Law; established, re-established, monumented, recovered, found as expressed below:

NOTE: Not more than 2 corners, all in the same town and range, may be recorded on this certificate.

A. Description of original monument and accessories and/or subsequent restoration:

(D10) Center of Section 29. Not established in the original survey. Found no subsequent record. 1896-County Surveyor F.H.Brown worked in this area but I found no record of his having subdivided this section.

(16-Sec. 29) East 1/16 corner between Sections 29 and 32. Not established in the original survey.

B. Description of corner evidence found and/or method applied in restoring or reestablishing corner:

(D10) Reestablished the corner at the intersection of old fence lines north, south, and west. The fences are in poor condition, wire down on ground. The position thus established falls only 3.4' at a bearing of S55E from the intersection of straight lines connecting opposite 1/4 corners. This close agreement suggests very strongly that this section was properly subdivided long ago and that the fence was constructed in accordance with the subdivision. I accept the fence intersection location as a careful and faithful determination of the position of the corner and monument same.

(16-Sec. 29) Established the corner midway and on the section line between Quarter corner 1323.97' west and Section corner 1323.97' east. The corner lies approx. 6' south of the centerline of a trail.

C. Description of monument for corner and accessories established to perpetuate locating the position of the corner:


(D10) Set 1"IDx36" I.pipe with plastic cap
 MDNR "MI DNR PS33986". Set measuring nails in:
 Power pole '97' N67W 11.75'
 12" Balsam S38E 63.8' mrkd "CS BT"
 6" Spruce S11W 69.65' do
 13" Spruce S41W 69.55' do
 Bearings are magnetic. Distances are to nail with MDNR tag in side of object.

(16-Sec. 29) Set 1"IDx36" I.pipe with 4" aluminum cap. Set measuring nails/MDNR tags in:
 5" Balsam N26E 16.88' marked "E1/16 BT"
 5" Balsam N36W 21.82' do
 6" Balsam S35E 37.33' do
 8" Spruce N75E 45.83' do
 Bearings are magnetic. Distance are to nail with tag in side of tree.

	A	B	C	D	E	F	G	H	I	J	K	L	M
1													
2	6		5		4		3		2		1		
3													
4	7		8		9		10		11		12		
5													
6	18		17		16		15		14		13		
7													
8	19		20		21		22		23		24		
9													
10	30		29		28		27		26		25		
11													
12	31		32		33		34		35		36		
13													

Signed by

Stephan J. Szyszkoski

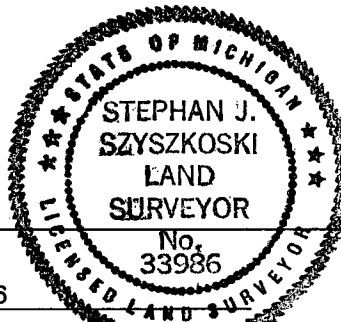

Date

9/11/07

Surveyor's Michigan License No.

33986