

MAR 09 1994

COMMISSION

Chippewa County Remonumentation Corner

LAND CORNER RECORDATION CERTIFICATE  
Filing Requirement of Act 74, Mich. P.A. 1970

RECEIVED FOR RECORD  
CHIPPEWA COUNTY  
STATE OF MICHIGAN

93 DEC 29 PM 2:49

*J. Roy Mabie*  
REGISTER OF DEEDS


For corners in  
Chippewa  
(County)

Located In: Corner Code #

1. Public Land Survey	T <u>44N</u> R <u>2E</u>	<u>E-13</u>
	T _____ R _____	_____
	T _____ R _____	_____
	T _____ R _____	_____
2. Property Controlling in Section	S _____ T _____ R _____	_____
	S _____ T _____ R _____	_____
3. Miscellaneous Property in Sec.	S _____ T _____ R _____	_____
	S _____ T _____ R _____	_____

Register of Deeds Stamp & File Number

- 4. Lot No. \_\_\_\_\_, Recorded Plat \_\_\_\_\_
- 5. Private Claims \_\_\_\_\_

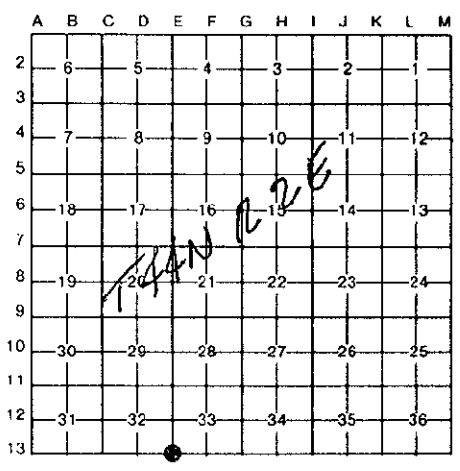

I, William L. Karr, in a field survey on December 16, 19 93 do hereby certify that under requirements of P.A. 74, Michigan P.A. of 1970, the corner points mentioned in lines 1 and 2 above were in conformance with regulations and rules therefore as required in the current manual of survey instructions of the United States Department of the Interior, Bureau of Land Management or by a decree of a Court of Law and/or that the corner points mentioned in lines 3, 4 and 5 above were in conformance with the rules of the Michigan Board of Land Surveyors or by a Decree of a Court of Law; established, re-established, monumented, re-monumented, recovered, found as expressed below:

**NOTE: Not more than 4 corners, all in the same town and range, may be recorded on this certificate.**

A. Description of original monument and accessories and/or subsequent restoration:  
(E-13) Standard Corner of Sections 32 & 33, (T44N-R2E)

1963: Neil Sperhake, L.S. 7876 (Kimberly Clark Corp.) Witness Corner recorded in Liber 3, Page 115 of the Chippewa County Corner Records.  
Re-established corner position using 1895 County Surveyor distances for East-West location and centerline Gogomain Road for North-South position. Set a 1" pipe with a stamped aluminum cap as a Witness Corner 33' North. Witnessed the Witness Corner.

B. Description of corner evidence found and/or method applied in restoring or reestablishing corner:  
(E-13) This corner is being perpetuated as part of the Chippewa County Remonumentation Program.

Found a PK nail 33.12' South of record Witness Monument to the North. Distance West to the South 1/4 of Section 32 is 2669.64' (Sperhake - 2668.05). Accepted corner position as found and offset prior to road reconstruction. Replaced corner after construction completed.


C. Description of monument for corner and accessories established to perpetuate locating the position of the corner:  
(E-13) Corner is a 3/4" x 24" iron with plastic "Chippewa County Remonumentation" cap. Corner falls 1' North of centerline Gogomain Road (East-West, paved). Falls 12' West of centerline Old Woods Road to the North.

Witnesses:

1 1/4" O.D. Pipe with Stamped Aluminum Cap	North	33.12'
10" Maple	N22°E	48.55'
Power Pole	S62°E	91.00'
12" Cedar (Witness for Witness Corner)	S15°W	61.82'
9" Basswood in Clump	N68°W	112.51'
Closing Corner Sections 4 & 5	West	13.20'

Signed by William L. Karr Date 12/23/93

Surveyor's Michigan License No. 27450

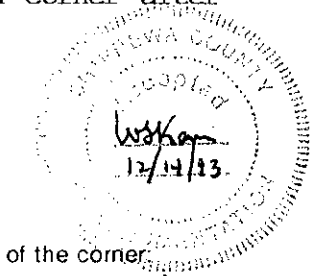

NOTE: Bearings are compass bearings corrected for declination. Distances are to a nail in side of witness objects unless noted.