

MAR 09 1994

Chippewa County Remonumentation Corner

RECEIVED FOR RECORD
CHIPPEWA COUNTY
STATE OF MICHIGAN

COMMISSION

LAND CORNER RECORDATION CERTIFICATE
Filing Requirement of Act 74, Mich. P.A. 1970

93 DEC 29 PM 2:49

For corners in
Chippewa

(County)

Located In:

Corner Code #

- 1. Public Land Survey T 44N R 2E H-13
T _____ R _____
T _____ R _____
T _____ R _____
- 2. Property Controlling S _____ T _____ R _____
in Section S _____ T _____ R _____
- 3. Miscellaneous S _____ T _____ R _____
Property in Sec. S _____ T _____ R _____
- 4. Lot No. _____, Recorded Plat _____
- 5. Private Claims _____

J. Roger Malott
REGISTER OF DEEDS

Register of Deeds Stamp & File Number

I, William L. Karr, in a field survey on December 21, 19 93, do hereby certify that under requirements of P.A. 74, Michigan P.A. of 1970, the corner points mentioned in lines 1 and 2 above were in conformance with regulations and rules therefore as required in the current manual of survey instructions of the United States Department of the Interior, Bureau of Land Management or by a decree of a Court of Law and/or that the corner points mentioned in lines 3, 4 and 5 above were in conformance with the rules of the Michigan Board of Land Surveyors or by a Decree of a Court of Law; established, re-established, monumented, re-monumented, recovered, found as expressed below:

A	B	C	D	E	F	G	H	I	J	K	L	M
2	6	5	4	3	2	1						
3												
4	7	8	9	10	11	12						
5												
6	18	17	16	15	14	13						
7												
8	19	20	21	22	23	24						
9												
10	30	29	28	27	26	25						
11												
12	31	32	33	34	35	36						
13												

NOTE: Not more than 4 corners, all in the same town and range, may be recorded on this certificate.

A. Description of original monument and accessories and/or subsequent restoration:

(H-13) South 1/4 Corner of Section 34 (T44N-R2E)

1963: Neal Sperhake recovered a large post with two smaller posts beside it believed to have been set in an 1895 survey of the Township Line. He re-established the corner based on these posts. Set a 1" galvanized iron pipe with stamped aluminum cap (Kimberly Clark) as a witness corner 25' North of the 1/4 Corner position with one witness.

Aspen 7 N43°W 79 links

Corner was 64 links (42.24') East of the North 1/4 Corner of Section 3.

Witness corner was recorded in Liber 3, Page 113 of the Chippewa County

Corner Records in September of 1977.

B. Description of corner evidence found and/or method applied in restoring or reestablishing corner:

(H-13) This corner is being re-established as part of the Chippewa County Remonumentation Program.

Did not find the Witness Corner. Re-established corner position 42.24' East of the North 1/4 Corner of Section 3 and on the extension of a straight line between the Southwest corner of Section 34 and the said North 1/4 Corner of Section 3.




C. Description of monument for corner and accessories established to perpetuate locating the position of the corner:

(H-13) Corner is a 3/4" x 24" iron with plastic "Chippewa County Remonumentation" cap. Falls 2' North of the centerline of Gogomain Road (East-West, paved).

Witnesses:

- Power Pole N77°E 101.33'
- 4" Ash S37°E 64.61'
- 7" Balsam S20°E 53.48'
- 3" Cedar N20°W 56.55'
- North 1/4 Corner Section 3 West 42.24'

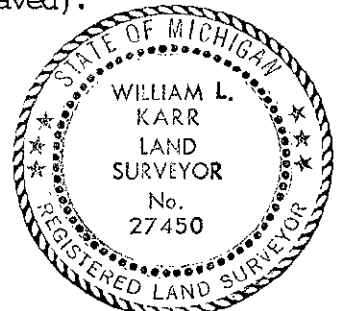

Signed by William L. Karr Date 12/23/93

Surveyor's Michigan License No. 27450

NOTE: Bearings are compass bearings corrected for declination. Distances are to a nail in side of witness objects unless noted.