

MAR 09 1994

COMMISSION

Chippewa County Remonumentation Corner

RECEIVED FOR RECORD
CHIPPEWA COUNTY
STATE OF MICHIGAN

LAND CORNER RECORDATION CERTIFICATE
Filing Requirement of Act 74, Mich. P.A. 1970

93 DEC 29 PM 2: 50

For corners in
Chippewa
(County)

Located In: Corner Code #


1. Public Land Survey	T <u>44N</u> R <u>2E</u>	I-13
	T _____ R _____	_____
	T _____ R _____	_____
	T _____ R _____	_____
2. Property Controlling in Section	S _____ T _____ R _____	_____
	S _____ T _____ R _____	_____
3. Miscellaneous Property in Sec.	S _____ T _____ R _____	_____
	S _____ T _____ R _____	_____

J. Roger Malott
REGISTER OF DEEDS

Register of Deeds Stamp & File Number

4. Lot No. _____, Recorded Plat _____
5. Private Claims _____

I, William L. Karr, in a field survey on December 8, 19 93, do hereby certify that under requirements of P.A. 74, Michigan P.A. of 1970, the corner points mentioned in lines 1 and 2 above were in conformance with regulations and rules therefore as required in the current manual of survey instructions of the United States Department of the Interior, Bureau of Land Management or by a decree of a Court of Law and/or that the corner points mentioned in lines 3, 4 and 5 above were in conformance with the rules of the Michigan Board of Land Surveyors or by a Decree of a Court of Law; established, re-established, monumented, re-monumented, recovered, found as expressed below:

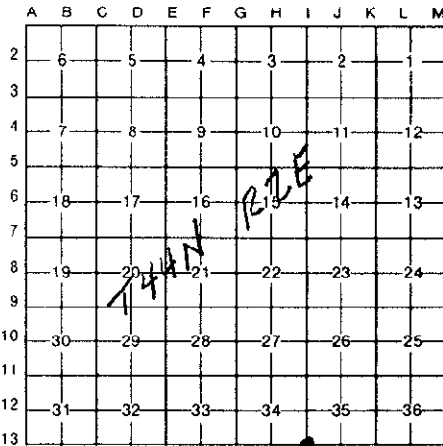

NOTE: Not more than 4 corners, all in the same town and range, may be recorded on this certificate.

A. Description of original monument and accessories and/or subsequent restoration:

(I-13) Standard Corner of Sections 34 & 35 (T44N-R2E)

1963: Neal Sperhake, L.S. 7876 (Kimberly Clark Corp.). Witness Corner recorded in Liber 3, Page 107 of the Chippewa County Corner Records. Re-established corner 50.82' East of Closing Corner. Set a 1" pipe with stamped aluminum cap as a Witness Corner 33' South. Witnessed the Witness Corner.

1978: Ronald R. Bischer, L.S. 22428. Corner recorded in Liber 1, Page 345 of the Chippewa County Corner Records. Found bent boat spike and replaced with a 1/2" rod.

Kimberly Clark Monument	North	33.00'
6" Black Ash	N27°E	67.26'
Kimberly Clark Monument	S62°W	58.60'

B. Description of corner evidence found and/or method applied in restoring or reestablishing corner:

(I-13) This corner is being perpetuated as part of the Chippewa County Remonumentation Program.

Found a 1/2" iron 6' South of centerline of Gogomain Road. Found disturbed record witness monument to the North. Found witness monument to closing corner (1 1/4" pipe with stamped aluminum cap) and the Black Ash bearing tree as recorded by Bischer. Found grown over nail with L.S. 15410 tag in side of Ash. Distances from the 1/2" iron to record witness objects checked well. Accepted corner position as found and offset it prior to road reconstruction. Replaced corner after construction completed. Added two additional witnesses. Placed nail and tag above nail in Ash.

C. Description of monument for corner and accessories established to perpetuate locating the position of the corner:

(I-13) Corner is a 3/4" x 24" iron with plastic "Chippewa County Remonumentation" cap. Corner falls 6' South of the centerline Gogomain Road (East-West, paved).

Witnesses:

8" Ash of Twin	N22°E	67.32'	(existing-new nail)
7" Maple	S30°E	64.97'	
1 1/4" O.D. Pipe with Stamped Aluminum Cap (Witness Monument to Closing Corner)	S62°W	58.97'	(existing)
Railroad Spike Set in Top of Boulder	N26°W	48.18'	(Common Witness)
Closing Corner Sections 2 & 3	West	50.82'	



Signed by William L. Karr Date 12/29/93

Surveyor's Michigan License No. 27450

NOTE: Bearings are compass bearings corrected for declination.

Distances are to a nail in side of witness objects unless noted.