

MAR 09 1994

LAND CORNER RECORDATION CERTIFICATE  
Filing Requirement of Act 74, Mich. P.A. 1970

93 DEC 29 PM 2: 51


For corners in COMMISSION  
Chippewa

*J. Ryan Mahall*  
REGISTER OF DEEDS

| (County)                           | Located In:              | Corner Code #/ |
|------------------------------------|--------------------------|----------------|
| 1. Public Land Survey              | T <u>44N</u> R <u>2E</u> | <u>K-13</u>    |
|                                    | T _____ R _____          | _____          |
|                                    | T _____ R _____          | _____          |
|                                    | T _____ R _____          | _____          |
| 2. Property Controlling in Section | S _____ T _____ R _____  | _____          |
|                                    | S _____ T _____ R _____  | _____          |
| 3. Miscellaneous Property in Sec.  | S _____ T _____ R _____  | _____          |
|                                    | S _____ T _____ R _____  | _____          |

Register of Deeds Stamp & File Number

- 4. Lot No. \_\_\_\_\_, Recorded Plat \_\_\_\_\_
- 5. Private Claims \_\_\_\_\_

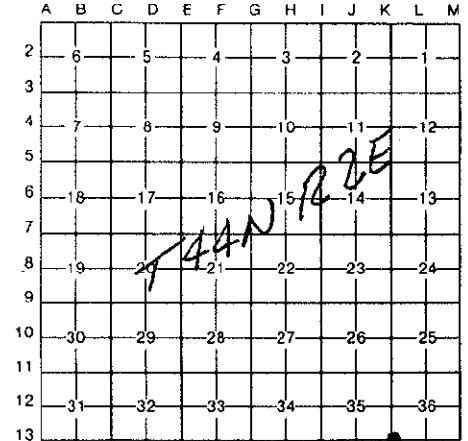

I, William L. Karr, in a field survey on December 15, 19 93, do hereby certify that under requirements of P.A. 74, Michigan P.A. of 1970, the corner points mentioned in lines 1 and 2 above were in conformance with regulations and rules therefore as required in the current manual of survey instructions of the United States Department of the Interior, Bureau of Land Management or by a decree of a Court of Law and/or that the corner points mentioned in lines 3, 4 and 5 above were in conformance with the rules of the Michigan Board of Land Surveyors or by a Decree of a Court of Law; established, re-established, monumented, re-monumented, recovered, found as expressed below:

NOTE: Not more than 4 corners, all in the same town and range, may be recorded on this certificate.


A. Description of original monument and accessories and/or subsequent restoration:  
(K-13) Standard Corner Common to Sections 35 & 36 (T44N-R2E)

This corner was re-established by Neal Sperhake, L.S. 7876 on August 8, 1963 and recorded in Liber 3, Page 105 of the Chippewa County Corner Records in 1977. He recovered a scribed wood post laying on the ground and two witnesses believed to have been established by the County Surveyor in an 1895 survey of the Township Line. Closing Corner 2/1 and the South 1/4 corner of Section 36 had been previously recovered and Sperhake re-established Standard Corner 35/36 48 links East of the Closing Corner 2/1 on this line.

Witnesses: Cedar 6 N41°W 7 1/2 links Cedar 12 N77°W 37 links  
Cedar 7 N69°E 58 1/2 links Cedar Stump 8 N32°E 46 links

B. Description of corner evidence found and/or method applied in restoring or reestablishing corner:  
(K-13) This corner is being perpetuated as part of the Chippewa County Remonumentation Program.

Found a galvanized iron pipe with Kimberly-Clark aluminum cap as described in Liber 3, Page 105. Accepted corner position as found and added three new witnesses.

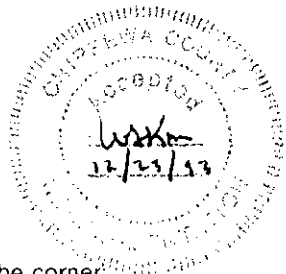

C. Description of monument for corner and accessories established to perpetuate locating the position of the corner:  
(K-13) Corner is a 1" galvanized pipe with "Kimberly-Clark" aluminum cap, on an East-West brush line.

Witnesses:  
12" Cedar N53°E 14.22'  
4" Cedar S49°E 11.95'  
6" Balsam S18°W 16.49'  
6" Cedar N02°W 9.35'  
Closing Corner 2/1 West 31.91'



Signed by William L. Karr Date 12/23/93