

MAR 16 1999

LAND CORNER RECORDATION CERTIFICATE
Filing Requirement of Act 74, Mich. P.A. 1970
Chippewa County Remonumentation Corner

SECTION

For corners in

Chippewa County	Located in:	Corner Code #
1. Public Land Survey	T44N R2W	A-5 } Same ✓ T44N R3W } Corner
	T R	
	T R	
2. Property Controlling in Section	S	T R
	S	T R
3. Miscellaneous Property in Sec.	S	T R
	S	T R
4. Lot No.		, Recorded Plat
5. Private Claims		

\$7.00 LAND CORNER
\$2.00 MSSR
5 MAR 1999 10:37:43 AM Receipt #14013
RECEIVED FOR RECORD
CHIPPEWA COUNTY - STATE OF MICHIGAN
SHARON H. KENNEDY, REGISTER OF DEEDS

BOOK 10 PAGE 384
Register of Deeds Stamp & File Number

I, Keith R. Waters, in a field survey on October 12, 1998, do hereby state that under requirements of P.A. 74, Michigan P.A. of 1970, the corner points mentioned in lines 1 and 2 above were in conformance with regulations and rules therefore as required in the current manual of survey instructions of the United States Department of the Interior, Bureau of Land Management or by a decree of a Court of Law and/or that the corner points mentioned in lines 3, 4 and 5 above were in conformance with the rules of the Michigan Board of Land Surveyors or by a Decree of a Court of Law; established, re-established, monumented, recovered, found as expressed below:

NOTE: Not more than 2 corners, all in the same town and range, may be recorded on this certificate.

A. Description of original monument and accessories and/or subsequent restoration:


A-5 Cor. Common to Secs. 7&18, T44N, R2W & Secs. 12&13, T44N, R3W

1840 - Original corner established by William A. Burt.

Witnesses: Pine 36, S78°W 20 links - Fir 10, N03°W 27 links.

1908 - Chippewa County Surveyor Frederick H. Brown, RLS 944, notes for Section 7 indicate "I set the southwest and southeast corners, but did not measure the south line." His sketch shows a distance of 5280 on the west line of Section 7, with distances of 2640 on each 1/2 mile.

Circa 1972 - Certificate of Survey, Harry W. Goodwin, RLS 5434. A sketch of Section 7 is shown with the record GLO distances, above mentioned Brown distances, and some measured distances. The sketch indicates that the southwest corner of said Section 7 was neither recovered or reestablished.

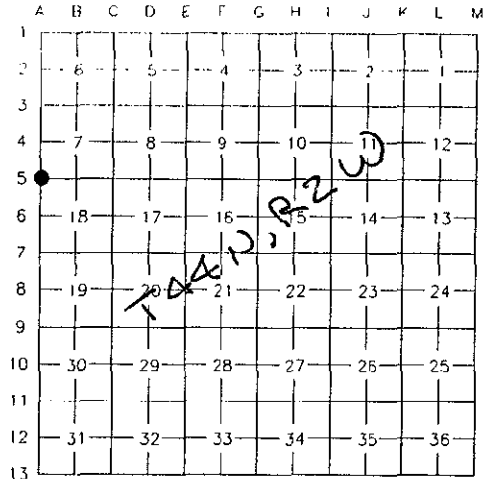

B. Description of corner evidence found and/or method applied in restoring or reestablishing corner:

This corner is being reestablished as part of the Chippewa County Remonumentation Program.

Found no evidence of the corner. Reestablished the corner by single proportionate measurement on the range line between recovered corners at A-4 and A-11. The distance between this reestablished corner and the 1/4 corner at A-4 to the north is within 0.6' of the above mentioned Brown notes.



C. Description of monument for corner and accessories established to perpetuate locating the position of the corner:

Placed a 3/4" rebar with a stamped aluminum Chippewa County Remonumentation cap at the corner location, which falls approximately 10 feet south of an east-west ATV trail. Witnesses:

- Nail and plastic witness tag #33142 in side of blazed 6" Spruce, S48°W 10.25'
- Nail and plastic witness tag #33142 in side of blazed 7" Spruce, S18°W 4.30'
- Nail and plastic witness tag #33142 in side of blazed 7" White Birch, N52°W 1.38'
- Nail and plastic witness tag #33142 in side of blazed 5" Spruce, N35°E 2.85'



Signed by Keith R. Waters

Date 12-30-98

Surveyor's Michigan License No. 33142