

MAR 27 1996

CHIPPEWA COUNTY REMONUMENTATION CORNER

LAND CORNER RECORDATION CERTIFICATE
Filing Requirement of Act 74, Mich. P.A. 1970

For corners in

COMMISSION

Chippewa

(County)

Located In:

Corner Code #

1. Public Land Survey

T44N R 2W

A-13 Same

T43N R 2W

A-1 Corner

T44N R 3W

M-13 (Township

T43N R 3W

M-1 Corner)

2. Property Controlling
in Section

S T R

S T R

3. Miscellaneous
Property in Sec.

S T R

S T R

\$ 7.00 LAND CORNER

\$ 2.00 MSSR

28 FEB 96 4:31 P.M. RECEIPT# 459

RECEIVED FOR RECORD

CHIPPEWA COUNTY - STATE OF MICHIGAN
SHARON H. KENNEDY, REGISTER OF DEEDS

Register of Deeds Stamp & File Number

4. Lot No. _____, Recorded Plat _____
5. Private Claims _____

I, Keith R. Waters, in a field survey on 12/19, 19 95 do hereby state that under requirements of P.A. 74, Michigan P.A. of 1970, the corner points mentioned in lines 1 and 2 above were in conformance with regulations and rules therefore as required in the current manual of survey instructions of the United States Department of the Interior, Bureau of Land Management or by a decree of a Court of Law and /or that the corner points mentioned in lines 3, 4 and 5 above were in conformance with the rules of the Michigan Board of Land Surveyors or by a Decree of a Court of Law; established, re-established, monumented, recovered, found as expressed below:

NOTE: Not more than 2 corners, all in the same town and range, may be recorded on this certificate.

	A	B	C	D	E	F	G	H	I	J	K	L	M
1													
2	6		5		4		3		2		1		
3													
4	7		8		9		10		11		12		
5													
6	18		17		16		15		14		13		
7													
8	19		20		21		22		23		24		
9													
10	30		29		28		27		26		25		
11													
12	31		32		33		34		35		36		
13													

A. Description of original monument and accessories and/or subsequent restoration:

A-13 Township Corner Common to T43N, R2W & T43N, R3W & T44N, R2W & T44N, R3W

1840 - Original ties (Wm. A. Burt): Elm 18, S30°E 19 links - Fir 16, N50°W 27 links

1967 - Ray Walker, M.S.H.D., as recorded in liber 3, page 229, Chippewa County recorded corners. Found 1" iron pin in mon. box.

1983 - U.S. Forest Service, as recorded in C-40, Mackinac County recorded corners. Found 1" iron pin a monument box along with 1 bearing tree from 1967 records.


1993 - Neil E. Hill, P.S. 27447, Mackinac County Remonumentation Surveyor, as recorded in D-223, Mackinac County recorded corners. Found 1" iron pin in a monument box along with the following witness objects:

Power Pole, N81°E 125.7' - 10" Aspen, S71°W 125.3' - Post, S65°E 24.5' - 12" Spruce, S54°E 75.3' - 8" Red Pine, N65°W 73.4'

B. Description of corner evidence found and/or method applied in restoring or reestablishing corner:

This corner is being perpetuated as part of the Chippewa County Remonumentation Program.

Found a 5/8" iron pin in a monument box 8.5 feet east of the centerline of Mackinac Trail. Also found all five witness objects as called for in 1993 Mackinac County LCRC. Accepted corner as found.

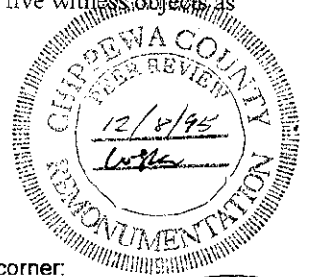

C. Description of monument for corner and accessories established to perpetuate locating the position of the corner:

Corner is a 5/8" iron pin in a monument box 8.5 feet east of the centerline of Mackinac Trail. Witnesses:

Power Pole, N81°E 125.7'

Note: Trees are blazed, painted, and tagged with metal bearing tree signs.

10" Aspen, S71°W 125.3'

Post, S65°E 24.5'

12" Spruce, S54°E 75.3'

8" Red Pine, N65°W 73.4'



Signed by Keith R. Waters

Date December 29, 1995

Surveyor's Michigan License No. 33142