

MAR 13 1999

LAND CORNER RECORDATION CERTIFICATE  
 Filing Requirement of Act 74, Mich. P.A. 1970  
 Chippewa County Remonumentation Corner

For corners in

Chippewa County SECTION	Located in:	Corner Code #
1. Public Land Survey	T44N R2W	B-5
	T R	
	T R	
	T R	
2. Property Controlling in Section	S T R	
	S T R	
3. Miscellaneous Property in Sec.	S T R	
	S T R	
4. Lot No. , Recorded Plat		
5. Private Claims		

\$7.00 LAND CORNER  
 \$2.00 MSSR  
 5 MAR 1999 10:45:54 AM Receipt #14013  
 RECEIVED FOR RECORD  
 CHIPPEWA COUNTY - STATE OF MICHIGAN  
 SHARON H. KENNEDY, REGISTER OF DEEDS

BOOK 10 PAGE 391  
 Register of Deeds Stamp & File Number

I, Keith R. Waters, in a field survey on October 12, 1998, do hereby state that under requirements of P.A. 74, Michigan P.A. of 1970, the corner points mentioned in lines 1 and 2 above were in conformance with regulations and rules therefore as required in the current manual of survey instructions of the United States Department of the Interior, Bureau of Land Management or by a decree of a Court of Law and for that the corner points mentioned in lines 3, 4 and 5 above were in conformance with the rules of the Michigan Board of Land Surveyors or by a Decree of a Court of Law; established, re-established, monumented, recovered, found as expressed below:

NOTE: Not more than 2 corners, all in the same town and range, may be recorded on this certificate.

A. Description of original monument and accessories and/or subsequent restoration:

B-5 1/4 Corner Common to Sections 7 & 18, Town 44 North, Range 2 West

1840 - Original corner established by James Mullet.

Witnesses: Tamarack 20, S10°W 21 links - Fir 10, N40°E 18 links.

1908 - Chippewa County Surveyor Frederick H. Brown, RLS 944, notes for Section 7 indicate that he set the southeast and southwest corners of said Section, but did not measure the south line. His sketch shows a distance of 5332 feet on the south line, with distances of 2666 feet on each half mile.

Circa 1972 - Certificate of Survey, Harry W. Goodwin, RLS 5434. A sketch of Section 7 is shown with the original GLO distances on the south line of 40 chains and 39.75 chains on the east and west 1/2 miles respectively. Also shown are Brown's distances of 2666 feet for each 1/2 mile. The sketch indicates that neither the south 1/4 corner or the southwest corner of the section were recovered or reestablished.

B. Description of corner evidence found and/or method applied in restoring or reestablishing corner:


This corner is being reestablished as part of the Chippewa County Remonumentation Program.

Found no evidence of the corner location. Reestablished the corner by single proportionate measurement on line between recovered corner at C-5 and reestablished corner at A-5. Corner falls on the remains of an east-west fence line.

C. Description of monument for corner and accessories established to perpetuate locating the position of the corner:

Placed a 3/4" rebar with a stamped aluminum Chippewa County Remonumentation cap at the corner location, which falls on the remains of an east-west fence line. Witnesses:

- Nail and plastic witness tag #33142 in blazed 8" Spruce, N75°W 7.71'
- Nail and plastic witness tag #33142 in blazed 5" Spruce, N03°W 18.59'
- Nail and plastic witness tag #33142 in blazed 5" Spruce, S63°E 19.28'
- Nail and plastic witness tag #33142 in blazed 6" Spruce, S35°E 7.64'

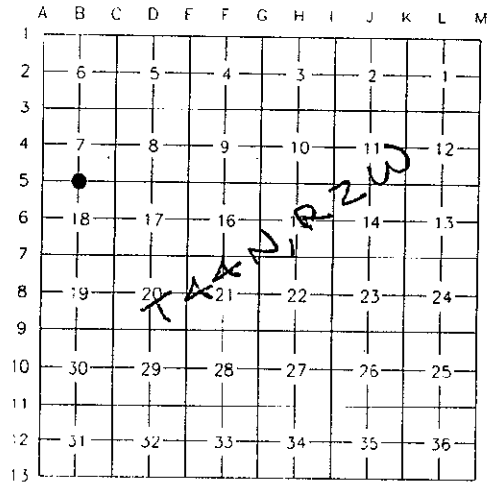

Signed by Keith R. Waters

Date 12-30-98

Surveyor's Michigan License No. 33142