

MAR 10 1999

SECTION

LAND CORNER RECORDATION CERTIFICATE  
Filing Requirement of Act 74, Mich. P.A. 1970  
Chippewa County Remonumentation Corner.

For corners in

Chippewa County	Located in:	Corner Code #
1. Public Land Survey	T44N R2W	B-11
	T R	
	T R	
	T R	
2. Property Controlling in Section	S T R	
	S T R	
3. Miscellaneous Property in Sec.	S T R	
	S T R	
4. Lot No. , Recorded Plat		
5. Private Claims		

\$7.00 LAND CORNER  
 \$2.00 MSSR  
 5 MAR 1999 10:47:58 AM Receipt #14013  
 RECEIVED FOR RECORD  
 CHIPPEWA COUNTY - STATE OF MICHIGAN  
 SHARON H. KENNEDY, REGISTER OF DEEDS

BOOK 10 PAGE 393  
 Register of Deeds Stamp & File Number

I, Keith R. Waters, in a field survey on April 30, 1998, do hereby state that under requirements of P.A. 74, Michigan P.A. of 1970, the corner points mentioned in lines 1 and 2 above were in conformance with regulations and rules therefore as required in the current manual of survey instructions of the United States Department of the Interior, Bureau of Land Management or by a decree of a Court of Law and for that the corner points mentioned in lines 3, 4 and 5 above were in conformance with the rules of the Michigan Board of Land Surveyors or by a Decree of a Court of Law; established, re-established, monumented, recovered, found as expressed below:

NOTE: Not more than 2 corners, all in the same town and range, may be recorded on this certificate.

A. Description of original monument and accessories and/or subsequent restoration:

B-11 1/4 Corner Common to Sections 30 & 31, T44N, R2W

1840 - Original corner established by James Mullett.

Witnesses: Fir 12, S14°W 15 links - Fir 8, N11°E 15 links.

1948 - Chippewa County Surveyor notes, Rudolph Larsen, RLS 3644, shows fence corner and iron pipe.

1959 - Michigan State Highway Department surveyor Ray Walker, liber 3, page 229, Chippewa County corner records.

1/4 corner found being 1 1/2" iron pipe. Witnesses:

6" Balm-O-Gilliad (Balm-of-Gilead Poplar), S50°W 12.45'

5" Balm-O-Gilliad (Balm-of-Gilead Poplar), S80°W 13.40'

4" Balm-O-Gilliad (Balm-of-Gilead Poplar), N70°E 23.76'

B. Description of corner evidence found and/or method applied in restoring or reestablishing corner:

This corner is being perpetuated as part of the Chippewa County Remonumentation Program.

Found a Highway Department nail and brass tag in the record 1959 bearing tree shown at N70°E 23.76 feet. Tree is dead but still standing. Did not find the iron pipe or the other two bearing trees as described in the 1959 notes.

Reset the corner at record bearing and distance from the Highway Department tag. The corner position falls at the approximate intersection of the remains of old fence lines east, west, and south.

C. Description of monument for corner and accessories established to perpetuate locating the position of the corner:

Placed a 3/4" x 24" rebar with a stamped aluminum Chippewa County Remonumentation cap at the corner location.

Witnesses:



Nail and plastic witness tag #33142 in side of blazed 3" Balsam Fir, EAST 10.36'

Nail and plastic witness tag #33142 in side of blazed 7" Balsam Fir, N66°E 41.96'

Nail and plastic witness tag #33142 in side of blazed 5" Balsam Fir, S17°E 2.74'

Nail and plastic witness tag #33142 in side of blazed 4" Balsam Fir, N40°W 18.52'

Nail and brass Highway Department tag in side of 6" Snag, N70°E 23.76'

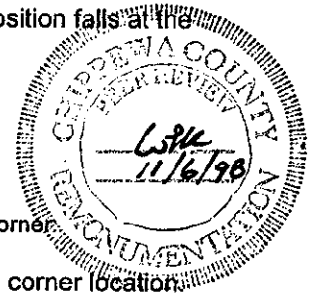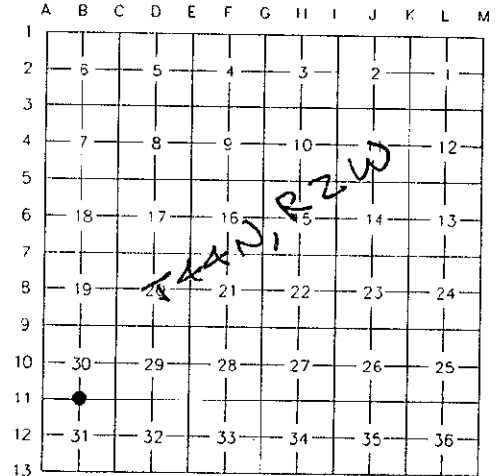

Signed by Keith R. Waters

Date 12-30-98

Surveyor's Michigan License No. 33142