

MAR 27 1995

CHIPPEWA COUNTY REMONUMENTATION CORNER

COMMISSION

LAND CORNER RECORDATION CERTIFICATE
Filing Requirement of Act 74, Mich. P.A. 1970

For corners in

Chippewa

(County)

Located In:

Corner Code #

1. Public Land Survey

T44N R 2W
T43N R 2W

B-13 Same
B-1 Corner

2. Property Controlling in Section

S T R
S T R

3. Miscellaneous Property in Sec.

S T R
S T R

\$ 7.00 LAND CORNER
\$ 2.00 MSSR
28 FEB 96 4:31 P.M. RECEIPT# 459
RECEIVED FOR RECORD
CHIPPEWA COUNTY - STATE OF MICHIGAN
SHARON H. KENNEDY, REGISTER OF DEEDS

Register of Deeds Stamp & File Number

4. Lot No. _____, Recorded Plat _____
5. Private Claims _____

I, Keith R. Waters, in a field survey on 12/19, 1995 do hereby state that under requirements of P.A. 74, Michigan P.A. of 1970, the corner points mentioned in lines 1 and 2 above were in conformance with regulations and rules therefore as required in the current manual of survey instructions of the United States Department of the Interior, Bureau of Land Management or by a decree of a Court of Law and for that the corner points mentioned in lines 3, 4 and 5 above were in conformance with the rules of the Michigan Board of Land Surveyors or by a Decree of a Court of Law; established, re-established, monumented, recovered, found as expressed below:

NOTE: Not more than 2 corners, all in the same town and range, may be recorded on this certificate.

	A	B	C	D	E	F	G	H	I	J	K	L	M
1													
2	6			5		4		3		2			
3													
4	7				8		9		10		11		12
5													
6	18				17		16		15		14		13
7													
8	19				20		21		22		23		24
9													
10	30				29		28		27		26		25
11													
12	31				32		33		34		35		36
13													

A. Description of original monument and accessories and/or subsequent restoration:

B-13 1/4 Corner Common to Section 6, T43N, R2W & Section 31, T44N, R2W

1840 - Original notes by William A. Burt indicate an 11" cedar for corner.

1989 - Richard L. Hays, P.S. 25847, as recorded in D-28, Mackinac County recorded corners. Corner was established by single proportionate measurement between recovered corners at the S.W. corner of Section 31 and the S.E. corner of Section 32, T44N, R2W.

1993 - Neil E. Hill, P.S. 27447, Mackinac County Remonumentation Surveyor, as recorded in D-229, Mackinac County recorded corners.


Found 2 1/2" x 3' monument with 3" aluminum cap and witness objects as called for in 1989 LCRC. Witnesses:

7" Maple, S71°E 22.16' - 4" Spruce, N65°W 13.98' - 9" Spruce, S83°W 22.41' - Cedar Post, EAST 1.50'

B. Description of corner evidence found and/or method applied in restoring or reestablishing corner:

This corner is being perpetuated as part of the Chippewa County Remonumentation Program.

Found a 2 1/2" x 3' monument with a 3" aluminum cap stamped to identify the corner. Also found witness objects as called for in Mackinac County LCRC.

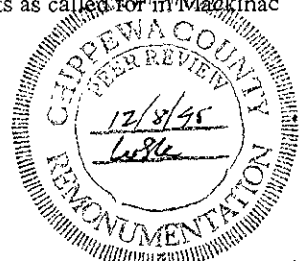

C. Description of monument for corner and accessories established to perpetuate locating the position of the corner:

Corner is a 2 1/2" x 3' monument with a stamped 3" aluminum cap. Witnesses:

7" Maple, S71°E 22.16'
4" Spruce, N65°W 13.98'
9" Spruce, S83°W 22.41'
Cedar Post, EAST 1.50'

Note: Trees are blazed and painted. Distances are to nail blaze.



Signed by Keith R. Waters
Surveyor's Michigan License No. 33142

Date December 29, 1995