

MAR 16 1999

LAND CORNER RECORDATION CERTIFICATE
Filing Requirement of Act 74, Mich. P.A. 1970
Chippewa County Remonumentation Corner

For corners in **SECTION**


Chippewa County	Located in:	Corner Code #
1. Public Land Survey	T44N R2W	C-2
	T R	
	T R	
	T R	
2. Property Controlling in Section	S T R	
	S T R	
3. Miscellaneous Property in Sec.	S T R	
	S T R	
4. Lot No. , Recorded Plat		
5. Private Claims		

\$7.00 LAND CORNER
 \$2.00 NCSR
 5 MAR 1999 10:48:36 AM Receipt #14013
 RECEIVED FOR RECORD
 CHIPPEWA COUNTY - STATE OF MICHIGAN
 SHARON H. KENNEDY, REGISTER OF DEEDS

BOOK 10 PAGE 394
 Register of Deeds Stamp & File Number

I, Keith R. Waters, in a field survey on November 20, 1998, do hereby state that under requirements of P.A. 74, Michigan P.A. of 1970, the corner points mentioned in lines 1 and 2 above were in conformance with regulations and rules therefore as required in the current manual of survey instructions of the United States Department of the Interior, Bureau of Land Management or by a decree of a Court of Law and /or that the corner points mentioned in lines 3, 4 and 5 above were in conformance with the rules of the Michigan Board of Land Surveyors or by a Decree of a Court of Law; established, re-established, monumented, recovered, found as expressed below:

NOTE: Not more than 2 corners, all in the same town and range, may be recorded on this certificate.

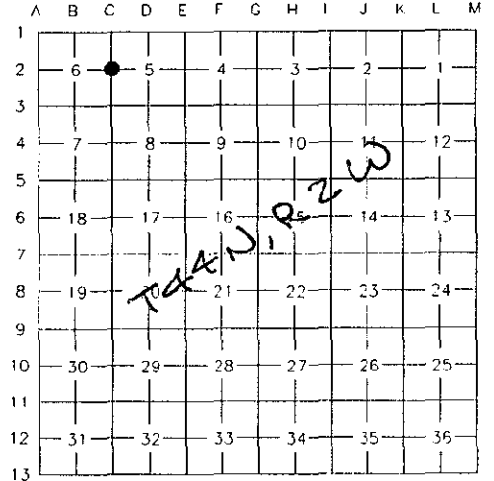

A. Description of original monument and accessories and/or subsequent restoration:

C-2 1/4 Corner Common to Sections 5 & 6, Town 44 North, Range 2 West

- 1845 - Original corner established by James Mullett.
 Witnesses: Cedar 20, N57°E 19 links - Cedar 18, S82°W 37 links.
- 1896 - Chippewa County Surveyor Frederick H. Brown, RLS 944, notes for Section 6 indicate that "the outside of this section was established by Carleton when he surveyed the Village of Rudyard and did not make any changes. Brown's sketch of Section 6 shows the east line with distances of 2640 feet and 2697 feet on the south and north 1/2 miles respectively. GLO distances were 2640 feet and 2711.3 feet.
- 1991 - Sketch of subdivision of Section 6, William L. Karr, P.S. 27450, indicates that the east 1/4 corner was computed by a proration of the above mentioned record County Surveyor distances between corners at C-1 and C-3.

B. Description of corner evidence found and/or method applied in restoring or reestablishing corner:

This corner is being reestablished as part of the Chippewa County Remonumentation Program. Found no evidence of the original corner. Reestablished corner on line between section corners C-1 to the north and C-3 to the south, at the proportionate distance according to the above mentioned County Surveyor notes. The overall mile distance is within approximately 2 feet of that as shown is said County Surveyor notes.



C. Description of monument for corner and accessories established to perpetuate locating the position of the corner:

Placed a 3/4" x 24" rebar with a plastic Chippewa County Remonumentation cap at the corner location, which falls approximately 1 foot west of the centerline of Tilson Road. Witnesses:

- Nail and plastic witness tag #33142 in side of Power Pole (E82), S12°W 202.99'
- Nail and plastic witness tag #33142 in side of Power Pole (E9501), S14°E 148.42'
- Nail and plastic witness tag #33142 in side of Power Pole (E81), N52°E 59.81'
- Nail and plastic witness tag #33142 in side of Power Pole (8001), N12°W 203.92'



Signed by Keith R. Waters

Date 12-30-98

Surveyor's Michigan License No. 33142