

MAR 18 1999

LAND CORNER RECORDATION CERTIFICATE
Filing Requirement of Act 74, Mich. P.A. 1970
Chippewa County Remonumentation Corner

SECTION

For corners in

Table with columns: Chippewa County, Located in:, Corner Code #. Rows include Public Land Survey, Property Controlling in Section, Miscellaneous Property in Sec., Lot No., and Private Claims.

\$7.00 LAND CORNER
\$2.00 MSSR
5 MAR 1999 10:52:39 AM Receipt #14013
RECEIVED FOR RECORD
CHIPPEWA COUNTY - STATE OF MICHIGAN
SHARON H. KENNEDY, REGISTER OF DEEDS

BOOK 10 PAGE 398
Register of Deeds Stamp & File Number

I, Keith R. Waters, in a field survey on November 25, 1998, do hereby state that under requirements of P.A. 74, Michigan P.A. of 1970, the corner points mentioned in lines 1 and 2 above were in conformance with regulations and rules therefore as required in the current manual of survey instructions of the United States Department of the Interior, Bureau of Land Management or by a decree of a Court of Law and /or that the corner points mentioned in lines 3, 4 and 5 above were in conformance with the rules of the Michigan Board of Land Surveyors or by a Decree of a Court of Law; established, re-established, monumented, recovered, found as expressed below:

NOTE: Not more than 2 corners, all in the same town and range, may be recorded on this certificate.

A. Description of original monument and accessories and/or subsequent restoration:

C-8 1/4 Corner Common to Sections 19 & 20, Town 44 North, Range 2 West

- 1845 - Original corner established by James Mullett. Witnesses: Fir 8, N24°W 12 links - Tamarack 12, S41°E 25 links.
1897 - Chippewa County Surveyor Frederick H. Brown, RLS 944, sketch of Section 20, shows the west line with distances of 2640 feet for both the north and south 1/2 miles.
1984 - Certificate of Survey, liber 449, page 573, Chippewa County records. Earl S. Strater, P.S. 28424, shows a set railroad spike at the corner location. Witnesses: RLS cap 28424 in south side of Power Pole (PD4/196/5), S85°W 98.97' RLS cap 28424 in north side of 12" Pine, S40°W 97.34' RLS cap 28424 in south side of Power Pole, S55°E 86.97' PK nail in Centerline M-48, N02°E 4.86'


B. Description of corner evidence found and/or method applied in restoring or reestablishing corner:

This corner is being perpetuated as part of the Chippewa County Remonumentation Program. Did not find the railroad spike as shown on the above mentioned Certificate of Survey. All evidence indicates that the railroad spike was set mid-way on line between section corners at C-7 and C-9, which is where I reset the corner. This position also works very well with a recorded corner at the south 1/16 corner between Sections 19 and 20.

C. Description of monument for corner and accessories established to perpetuate locating the position of the corner:

Set a 3/4" rebar with a plastic Chippewa County cap at the corner location, which falls in the approximate centerline of Mackinac Trail. Witnesses:

- Nail and plastic witness tag #33142 in side of Power Pole (RU1/6), N30°W 188.71'
Nail and plastic witness tag #33142 in side of Power Pole, N24°E 158.38'
Nail and plastic witness tag #33142 in side of Power Pole, S55°E 86.53'
Nail and plastic witness tag #33142 in side of Power Pole (RU1/5), S85°W 99.43'

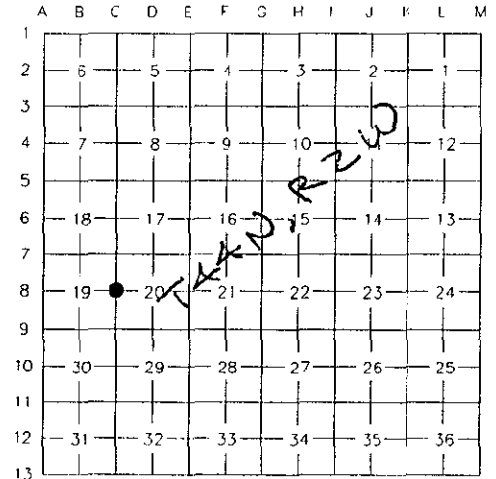

Signed by Keith R. Waters

Date 12-30-98

Surveyor's Michigan License No. 33142