

MAR 16 1999

LAND CORNER RECORDATION CERTIFICATE

Filing Requirement of Act 74, Mich. P.A. 1970 LAND CORNER  
Chippewa County Remonumentation Corner \$2.00 MSSR

SECTION

For corners in

Chippewa County	Located in:	Corner Code #
1. Public Land Survey	T44N R2W	C-11
	T R	
	T R	
	T R	
2. Property Controlling in Section	S T R	
	S T R	
3. Miscellaneous Property in Sec.	S T R	
	S T R	
4. Lot No. , Recorded Plat		
5. Private Claims		


5 MAR 1999 1:50:56 PM Receipt #14029  
RECEIVED FOR RECORD  
CHIPPewa COUNTY - STATE OF MICHIGAN  
SHARON H. KENNEDY, REGISTER OF DEEDS

BOOK 11 PAGE 1

Register of Deeds Stamp & File Number

I, Keith R. Waters, in a field survey on December 15, 1998, do hereby state that under requirements of P.A. 74, Michigan P.A. of 1970, the corner points mentioned in lines 1 and 2 above were in conformance with regulations and rules therefore as required in the current manual of survey instructions of the United States Department of the Interior, Bureau of Land Management or by a decree of a Court of Law and for that the corner points mentioned in lines 3, 4 and 5 above were in conformance with the rules of the Michigan Board of Land Surveyors or by a Decree of a Court of Law; established, re-established, monumented, recovered, found as expressed below:

NOTE: Not more than 2 corners, all in the same town and range, may be recorded on this certificate.

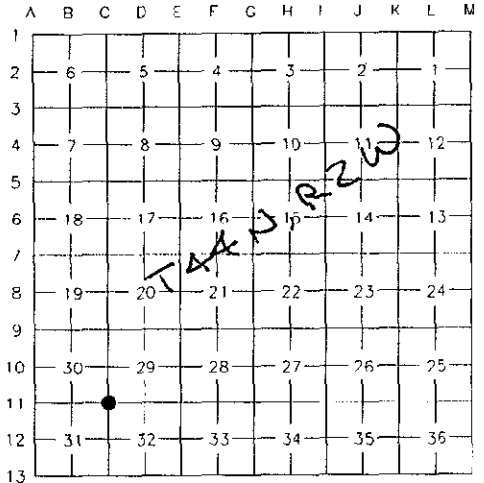

A. Description of original monument and accessories and/or subsequent restoration:

C-11 Corner Common to Sections 29, 30, 31, & 32, Town 44 North, Range 2 West

- 1845 - Original corner (12" Spruce) established by James Mullett.
- 1948 - Chippewa County Surveyor notes, Rudolph Larsen, RLS 3644. A sketch of Section 30 shows a distance of 2627 feet between a fence corner and iron pipe at 1/4 corner B-11 and an ironwood stake at section corner C-11.
- 1959 - Liber 3, page 229, Chippewa County corner records. Michigan State Highway Department surveyor Ray Walker, section corner found being wooden post. Witnesses:  
4" Balsam, S25°E 14.51' - 4" Balsam, N55°W 8.72' - 8" Elm, N45°E 23.52'.


B. Description of corner evidence found and/or method applied in restoring or reestablishing corner:

This corner is being reestablished as part of the Chippewa County Remonumentation Program. Found no evidence of the wooden post or any of the bearing trees as called for in the 1959 Highway Department records. After an extensive search of Highway Department and County Road Commission records, I could find no information regarding this corner other than the witnesses shown in liber 3, page 229. I reestablished the corner at the record distance of 2627 feet east of the 1/4 corner at B-11, as shown in the above mentioned 1948 Larsen notes. The latitude of the corner was established by proportionate measurement between recovered corners at C-9 and C-13. The distance between said corners at C-9 and C-13 is within 3.5 feet of the record GLO distance in 2 miles. (Note: An apparent intersection of old fence lines to the south and west was found bearing approximately S26°W 157 feet from my reestablished corner location. This fence corner was determined to be too far out of position from all adjacent corners to be considered as evidence of the corner location. I also did not use the position of the 1/4 corner at C-12 to reestablish the corner, as I do not believe that said 1/4 corner C-12 is a perpetuation of the original position).

C. Description of monument for corner and accessories established to perpetuate locating the position of the corner:

Placed a 3/4" x 24" rebar with a stamped aluminum Chippewa County Remonumentation cap at the corner location.  
Witnesses:

- Nail and plastic witness tag #33142 in side of blazed 15" White Oak, N30°W 8.88'
- Nail and plastic witness tag #33142 in side of blazed 18" White Oak, N30°E 14.98'
- Nail and plastic witness tag #33142 in side of blazed 12" White Oak, S66°E 19.12'
- Nail and plastic witness tag #33142 in side of blazed Twin 6" Maple, S64°W 17.20'

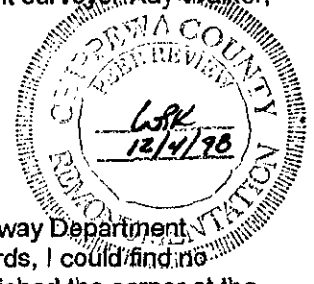

Signed by Keith R. Waters

Date 12-30-98

Surveyor's Michigan License No. 33142