

MAR 10 1999

LAND CORNER RECORDATION CERTIFICATE
Filing Requirement of Act 74, Mich. P.A. 1970
 Chippewa County Remonumentation Corner


For corners in **SECTION**

Chippewa County	Located In:	Corner Code #
1. Public Land Survey	T44N R2W	D-3
	T R	
	T R	
	T R	
2. Property Controlling in Section	S T R	
	S T R	
3. Miscellaneous Property in Sec.	S T R	
	S T R	
4. Lot No.		Recorded Plat
5. Private Claims		

\$7.00 LAND CORNER
 \$2.00 MSSR
 5 MAR 1999 1:52:52 PM Receipt #14029
 RECEIVED FOR RECORD
 CHIPPEWA COUNTY - STATE OF MICHIGAN
 SHARON H. KENNEDY, REGISTER OF DEEDS

BOOK 11 PAGE 3
 Register of Deeds Stamp & File Number

I, Keith R. Waters, in a field survey on April 2, 1998, do hereby state that under requirements of P.A. 74, Michigan P.A. of 1970, the corner points mentioned in lines 1 and 2 above were in conformance with regulations and rules therefore as required in the current manual of survey instructions of the United States Department of the Interior, Bureau of Land Management or by a decree of a Court of Law and/or that the corner points mentioned in lines 3, 4 and 5 above were in conformance with the rules of the Michigan Board of Land Surveyors or by a Decree of a Court of Law; established, re-established, monumented, recovered, found as expressed below:

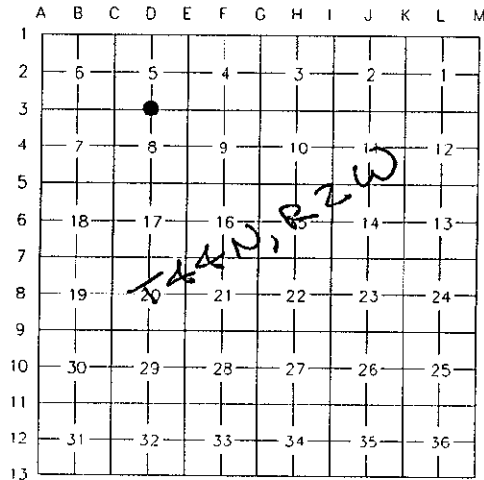

NOTE: Not more than 2 corners, all in the same town and range, may be recorded on this certificate.


A. Description of original monument and accessories and/or subsequent restoration:

D-3 1/4 Corner Common to Sections 5 & 8, T44N, R2W

- 1845 - Original corner established by James Mullett.
 Witnesses: Black Ash 10, N36°W 15 links - Spruce 8, S43°E 08 links.
- 1907 - Chippewa County Surveyor Frederick H. Brown, RLS 944. Sketch of Sections 5 and 8 shows various measurements on the line between said sections. It appears that the 1/4 corner was lost at that time.
- 1972 - Certificate of Survey, liber 1 of surveys, page 5. Mary C. Feindt, P.S. 3920, reestablished corner by single proportionate measurement between sections corners at C-3 and E-3.
- 1990 - LCRC, liber 9, page 144, Chippewa County corner records. Larry R. Rogers, P.S. 29251, found a boat spike and one witness object with tag #3920. Accepted corner as found. Witnesses:
 Power Pole, S06°W 72.67'
 "V" cut in end of 18" Metal Culvert, S40°W 86.52'
 "V" cut in end of 36" Metal Culvert, N08°W 47.53'
 "V" cut in end of 36" Metal Culvert, S10°E 45.16'

B. Description of corner evidence found and/or method applied in restoring or reestablishing corner:

This corner is being perpetuated as part of the Chippewa County Remonumentation Program. Found a boat spike and all record witness objects as called for in the above mentioned LCRC.

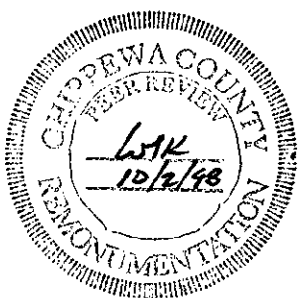

C. Description of monument for corner and accessories established to perpetuate locating the position of the corner:

- Found a boat spike at the corner location, which falls 0.8'± north of the centerline of Highway M-48. Witnesses:
 Nail and plastic witness tag #33142 in the top of a cut-off Power Pole, S06°W 72.63'
 "V" notch cut in end of 18" Metal Culvert, S40°W 86.52'
 "V" notch cut in end of 36" Metal Culvert, N08°W 47.53'
 "V" notch cut in end of 36" Metal Culvert, S10°E 45.16'



Signed by Keith R. Waters

Date 12-30-98

Surveyor's Michigan License No. 33142