

MAR 10 1999

SECTION

LAND CORNER RECORDATION CERTIFICATE
Filing Requirement of Act 74, Mich. P.A. 1970
Chippewa County Remonumentation Corner


For corners in

Table with columns: Chippewa County, Located in:, Corner Code #. Rows include Public Land Survey, Property Controlling in Section, Miscellaneous Property in Sec., Lot No., and Private Claims.

\$7.00 LAND CORNER
\$2.00 NSSR
5 MAR 1999 1:53:38 PM Receipt #14029
RECEIVED FOR RECORD
CHIPPEWA COUNTY - STATE OF MICHIGAN
SHARON H. KENNEDY, REGISTER OF DEEDS

BOOK 11 PAGE 4
Register of Deeds Stamp & File Number

I, Keith R. Waters, in a field survey on April 30, 1998, do hereby state that under requirements of P.A. 74, Michigan P.A. of 1970, the corner points mentioned in lines 1 and 2 above were in conformance with regulations and rules therefore as required in the current manual of survey instructions of the United States Department of the Interior, Bureau of Land Management or by a decree of a Court of Law and for that the corner points mentioned in lines 3, 4 and 5 above were in conformance with the rules of the Michigan Board of Land Surveyors or by a Decree of a Court of Law; established, re-established, monumented, recovered, found as expressed below:

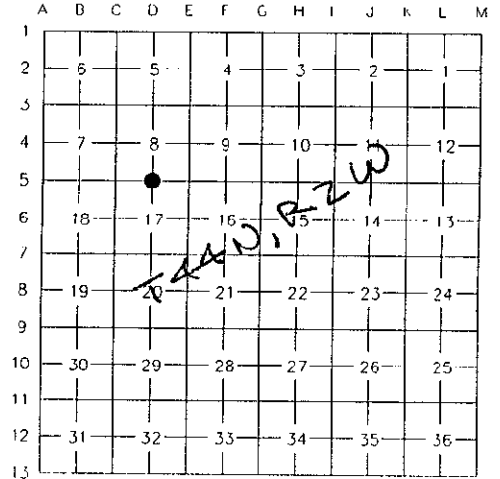

NOTE: Not more than 2 corners, all in the same town and range, may be recorded on this certificate.


A. Description of original monument and accessories and/or subsequent restoration:

D-5 1/4 Corner Common to Sections 8 & 17, T44N, R2W

- 1845 - Original corner established by James Mullett. Witnesses: Spruce 12, N26°E 55 links - Spruce 8, S45°W 19 links.
1907 - Chippewa County Surveyor Frederick H. Brown, RLS 944. Sketch of Section 8 shows the south line of said section with distances of 2631 feet for each 1/2 mile. He also notes a fence which is "too far west."
1959 - Liber 3, page 225, Chippewa County corner records. Michigan State Highway Department surveyor Ray Walker, found a 2" squared hub and replaced with a boat spike. Witnesses: Power Pole, S60°W 55.69' - Power Pole, N55°W 58.03' - Power Pole, N70°E 66.15'.

B. Description of corner evidence found and/or method applied in restoring or reestablishing corner:

This corner is being perpetuated as part of the Chippewa County Remonumentation Program. Found a boat spike approximately 5 feet north of the centerline of an east-west gravel road. All witness objects as called for in the 1959 Highway Department notes are gone. Distances to section corners east and west check well with those as shown in the 1907 County Surveyor notes. Accepted corner as found.

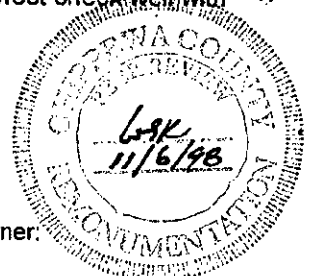

C. Description of monument for corner and accessories established to perpetuate locating the position of the corner:

Found a boat spike at the corner location, which falls approximately 5 feet north of the centerline of an east-west gravel road (20 Mile Road). Witnesses:

- Nail in side of Power Pole (404), S14°W 348.61'
Nail in side of Power Pole (403), S70°W 50.91'
Nail in side of Power Pole (402), N04°W 348.18'
Nail in side of Corner Fence Post, N28°E 29.43'



Signed by Keith R. Waters

Date 12-30-98

Surveyor's Michigan License No. 33142