

MAR 18 1999

SECTION

LAND CORNER RECORDATION CERTIFICATE
Filing Requirement of Act 74, Mich. P.A. 1970
Chippewa County Remonumentation Corner

For corners in

Table with columns: Chippewa County, Located in:, Corner Code #. Rows include Public Land Survey, Property Controlling in Section, Miscellaneous Property in Sec., Lot No., and Private Claims.

\$7.00 LAND CORNER
\$2.00 MSSR
5 MAR 1999 1:54:21 PM Receipt #14029
RECEIVED FOR RECORD
CHIPPEWA COUNTY - STATE OF MICHIGAN
SHARON H. KENNEDY, REGISTER OF DEEDS

BOOK 11 PAGE 5

Register of Deeds Stamp & File Number

I, Keith R. Waters, in a field survey on November 12, 1998, do hereby state that under requirements of P.A. 74, Michigan P.A. of 1970, the corner points mentioned in lines 1 and 2 above were in conformance with regulations and rules therefore as required in the current manual of survey instructions of the United States Department of the Interior, Bureau of Land Management or by a decree of a Court of Law and /or that the corner points mentioned in lines 3, 4 and 5 above were in conformance with the rules of the Michigan Board of Land Surveyors or by a Decree of a Court of Law; established, re-established, monumented, recovered, found as expressed below:


NOTE: Not more than 2 corners, all in the same town and range, may be recorded on this certificate.

A. Description of original monument and accessories and/or subsequent restoration:

D-7 1/4 Corner Common to Sections 17 & 20, T44N, R2W


1845 - Original corner established by James Mullett.
Witnesses: Spruce 4, N49°E 20 links - Maple 6, S14°W 15 links.

1897 - Chippewa County Surveyor Frederick H. Brown, RLS 944. Sketch of Section 20 shows the north line of said section with distances of 2610 feet for each 1/2 mile.

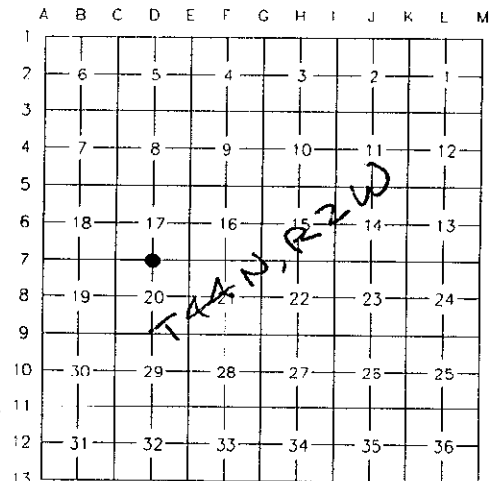

B. Description of corner evidence found and/or method applied in restoring or reestablishing corner:

This corner is being perpetuated as part of the Chippewa County Remonumentation Program. Found a boat spike in the north track of an east-west 2 track road. Boat spike is on line between section corner C-7 2615.12 feet to the west and section corner E-7 2606.85 feet to the east, on the extension of a field line to the south and remains of a fence line to the north. Accepted corner as found.

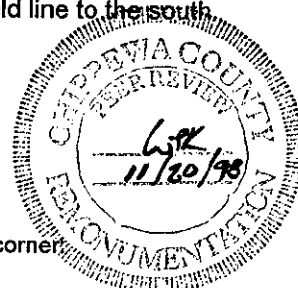

C. Description of monument for corner and accessories established to perpetuate locating the position of the corner:

Found a boat spike at the corner location, which falls in the north track of an east-west 2 track road, at a field line to the south and the remains of an old fence line to the north. Witnesses:

- Nail and plastic witness tag #33142 in side of Power Pole (418), N58°W 70.26'
Nail and plastic witness tag #33142 in side of Power Pole (419), S28°W 163.36'
Nail and plastic witness tag #33142 in side of Power Pole (420), S12°W 455.12'
Nail and plastic witness tag #33142 in side of Corner Fence Post, S02°E 27.16'



Signed by Keith R. Waters

Date 12-30-98

Surveyor's Michigan License No. 33142