

MAR 1 1999

SECTION

LAND CORNER RECORDATION CERTIFICATE

Filing Requirement of Act 74, Mich. P.A. 1970

Chippewa County Remonumentation Corner

\$7.00 LAND CORNER

\$2.00 MSSR

5 MAR 1999 1:56:29 PM Receipt #14029

RECEIVED FOR RECORD

CHIPPewa COUNTY - STATE OF MICHIGAN
SHARON H. KENNEDY, REGISTER OF DEEDS

BOOK 11 PAGE 8

Register of Deeds Stamp & File Number

For corners in

Chippewa County	Located in:	Corner Code #
1. Public Land Survey	T44N R2W	E-4
	T R	
	T R	
	T R	
2. Property Controlling in Section	S T R	
	S T R	
3. Miscellaneous Property in Sec.	S T R	
	S T R	
4. Lot No.		Recorded Plat
5. Private Claims		

I, Keith R. Waters, in a field survey on April 2, 1998, do hereby state that under requirements of P.A. 74, Michigan P.A. of 1970, the corner points mentioned in lines 1 and 2 above were in conformance with regulations and rules therefore as required in the current manual of survey instructions of the United States Department of the Interior, Bureau of Land Management or by a decree of a Court of Law and /or that the corner points mentioned in lines 3, 4 and 5 above were in conformance with the rules of the Michigan Board of Land Surveyors or by a Decree of a Court of Law; established, re-established, monumented, recovered, found as expressed below:

NOTE: Not more than 2 corners, all in the same town and range, may be recorded on this certificate.

A. Description of original monument and accessories and/or subsequent restoration:

E-4 1/4 Corner Common to Sections 8 & 9, T44N, R2W

1845 - Original corner (8" Tamarack) established by James Mullett.

1907 - Chippewa County Surveyor Frederick H. Brown, RLS 944. Notes for Section 8, "the east line was a road when I first saw it and was probably run from corner 20, 21, 28, & 29 (an original corner) north to some corner on town line. Brown's sketch shows a distance of 5280 feet on said east line.

1915 - Brown's notes for Section 9 show the west line with distances of 2642 feet on each 1/2 mile.

1986 - Larry R. Rogers, P.S. 29251, found a 1/2" iron, 1.5 feet below road surface, raised with 1/2" iron and cap #29251.

1997 - Certificate of Survey, Keith R. Waters, P.S. 33142. Corner shown as a found 1/2" iron. Witnesses:

Fence Post, N58°E 56.81' - Fence Post, N87°E 47.76' - Fence Post, S60°E 67.40 - Power Pole, S56°W 59.22'.

B. Description of corner evidence found and/or method applied in restoring or reestablishing corner:

This corner is being perpetuated as part of the Chippewa County Remonumentation Program.

Found a 1/2" rebar and all four witness objects as called for in the above mentioned 1997 Certificate of Survey. The found iron is 2641.0 feet from section corner to the north, 2642.5 feet from section corner to the south, and is 0.8 feet east of a straight line between said section corners. Accepted corner as found.

C. Description of monument for corner and accessories established to perpetuate locating the position of the corner:



Found a 1/2" rebar at the corner location, which falls in the approximate centerline of Centerline Road, on the extension of a fence line to the west, 6± south of a fence line to the east. Witnesses:

Nail and plastic witness tag in side of Fence Post, N58°E 56.81'

Nail and plastic witness tag in side of Fence Post, N87°E 47.76'

Nail and plastic witness tag in side of Fence Post, S60°E 67.40'

Nail and plastic witness tag in side of Power Pole, S56°W 59.22'

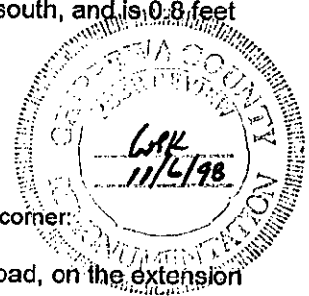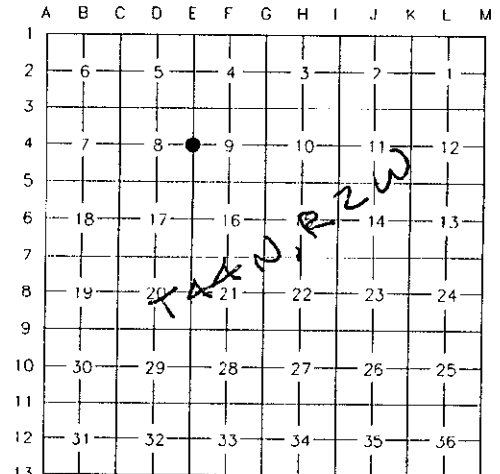

Signed by Keith R. Waters

Date 12-30-98

Surveyor's Michigan License No. 33142