

MAR 10 1999

SECTION

**LAND CORNER RECORDATION CERTIFICATE**  
**Filing Requirement of Act 74, Mich. P.A. 1970**  
**Chippewa County Remonumentation Corner**

For corners in

Chippewa County	Located in:	Corner Code #
1. Public Land Survey	T44N R2W	E-6
	T R	
	T R	
	T R	
2. Property Controlling in Section	S T R	
	S T R	
3. Miscellaneous Property in Sec.	S T R	
	S T R	
4. Lot No. , Recorded Plat		
5. Private Claims		

\$7.00 LAND CORNER  
\$2.00 NSSR  
5 MAR 1999 1:57:56 PM Receipt #14029  
RECEIVED FOR RECORD  
CHIPPEWA COUNTY - STATE OF MICHIGAN  
SHARON H. KENNEDY, REGISTER OF DEEDS

BOOK 11 PAGE 10  
Register of Deeds Stamp & File Number

I, Keith R. Waters, in a field survey on November 23, 1998, do hereby state that under requirements of P.A. 74, Michigan P.A. of 1970, the corner points mentioned in lines 1 and 2 above were in conformance with regulations and rules therefore as required in the current manual of survey instructions of the United States Department of the Interior, Bureau of Land Management or by a decree of a Court of Law and /or that the corner points mentioned in lines 3, 4 and 5 above were in conformance with the rules of the Michigan Board of Land Surveyors or by a Decree of a Court of Law; established, re-established, monumented, recovered, found as expressed below:



NOTE: Not more than 2 corners, all in the same town and range, may be recorded on this certificate.

A. Description of original monument and accessories and/or subsequent restoration:

E-6 1/4 Corner Common to Sections 16 & 17, T44N, R2W

1845 - Original corner established by James Mullett.  
Witnesses: Cedar 12, S25°W 08 links - Birch 6, N17°E 15 links.

1996 - Certificate of Survey, P.S. 22428. Corner shown as a 1/2" rod and cap midway on line between a 1" pipe at section corner E-5 to the north and a 1/2" rod at section corner E-7 to the south.

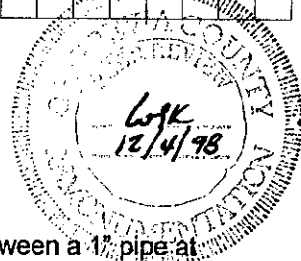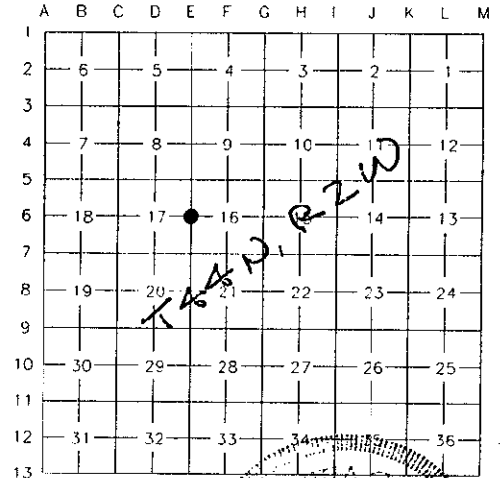

B. Description of corner evidence found and/or method applied in restoring or reestablishing corner:

This corner is being reestablished as part of the Chippewa County Remonumentation Program. Found no evidence of the original corner. Reestablished corner by single proportionate measurement midway on line between section corners E-5 to the north and E-7 to the south. (Note: The corner shown in the above mentioned Certificate of Survey was established using an erroneous location for the section corner E-7, and was removed to avoid confusion).

C. Description of monument for corner and accessories established to perpetuate locating the position of the corner:

Placed a 3/4" x 24" rebar with a plastic Chippewa County Remonumentation cap at the corner location, which falls in the approximate centerline of a north-south gravel road (Centerline Road). Witnesses:

- Nail and plastic witness tag #22428 in side of Power Pole, EAST 44.64'
- Nail and plastic witness tag #22428 in side of Power Pole, N88°W 42.94'
- Nail and plastic witness tag #33142 in side of Power Pole, N06°W 286.77'
- Nail and plastic witness tag #33142 in side of Power Pole, S12°W 257.30'



Signed by Keith R. Waters

Date 12-30-98

Surveyor's Michigan License No. 33142