

1999

SECTION

LAND CORNER RECORDATION CERTIFICATE

Filing Requirement of Act 74, Mich. P.A. 1970

Chippewa County Remonumentation Corner #7.00 LAND CORNER

For corners in

Chippewa County	Located in:	Corner Code #
1. Public Land Survey	T44N R2W	E-8
	T R	
	T R	
	T R	
2. Property Controlling in Section	S T R	
3. Miscellaneous Property in Sec.	S T R	
	S T R	
4. Lot No. , Recorded Plat		
5. Private Claims		

\$2.00 MSSR

5 MAR 1999 1:59:42 PM Receipt #14029

RECEIVED FOR RECORD

CHIPPewa COUNTY - STATE OF MICHIGAN  
SHARON H. KENNEDY, REGISTER OF DEEDS

BOOK 11 PAGE 12

Register of Deeds Stamp & File Number

I, Keith R. Waters, in a field survey on November 25, 1998, do hereby state that under requirements of P.A. 74, Michigan P.A. of 1970, the corner points mentioned in lines 1 and 2 above were in conformance with regulations and rules therefore as required in the current manual of survey instructions of the United States Department of the Interior, Bureau of Land Management or by a decree of a Court of Law and /or that the corner points mentioned in lines 3, 4 and 5 above were in conformance with the rules of the Michigan Board of Land Surveyors or by a Decree of a Court of Law; established, re-established, monumented, recovered, found as expressed below:

NOTE: Not more than 2 corners, all in the same town and range, may be recorded on this certificate.

A. Description of original monument and accessories and/or subsequent restoration:

E-8 1/4 Corner Common to Sections 20 & 21, T44N, R2W

1845 - Original corner established by James Mullett.

Witnesses: Spruce 8, N49°E 26 links - Spruce 8, N33°W 20 links.

Found no evidence of subsequent restoration of this corner.

B. Description of corner evidence found and/or method applied in restoring or reestablishing corner:

This corner is being perpetuated as part of the Chippewa County Remonumentation Program.

Found a 5/8" diameter smooth surfaced iron bar approximately 14" below the gravel road surface of Centerline Road. Found bar is 2635.4 feet from section corner E-7 to the north, 2633.4 feet from section corner E-9 to the south, and is 3.3 feet east of a straight line between said section corners. Accepted corner as found.

C. Description of monument for corner and accessories established to perpetuate locating the position of the corner:


Found a 5/8" diameter smooth surfaced iron bar approximately 14" below the gravel road surface at the corner location, which falls in the approximate centerline of Centerline Road, 11 feet north of a fence line to the east. Witnesses:

Nail and plastic witness tag #33142 in side of Power Pole, N10°W 207.39'

Nail and plastic witness tag #33142 in side of Power Pole, S30°W 91.70'

Nail and plastic witness tag #33142 in side of Power Pole, S10°W 359.44'

1/2" rebar with cap #33142 on East-West 1/4 Line of Section 21, EAST 50.00'

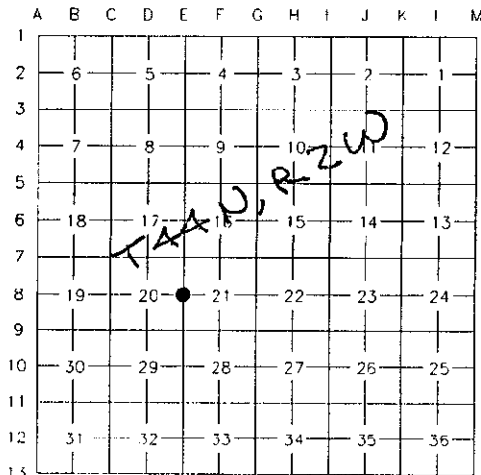

Signed by Keith R. Waters

Date 12-30-98

Surveyor's Michigan License No. 33142