

MAR 16 1999

LAND CORNER RECORDATION CERTIFICATE

Filing Requirement of Act 74, Mich. P.A. 1970

Chippewa County Remonumentation Corner \$7.00 LAND CORNER

SECTION

For corners in

Chippewa County	Located in:	Corner Code #
1. Public Land Survey	T44N R2W	E-12
	T R	
	T R	
	T R	
2. Property Controlling in Section	S T R	
	S T R	
3. Miscellaneous Property in Sec.	S T R	
	S T R	
4. Lot No.		Recorded Plat
5. Private Claims		

\$2.00 NSSR
 5 MAR 1999 2:02:18 PM Receipt #14029
 RECEIVED FOR RECORD
 CHIPPEWA COUNTY - STATE OF MICHIGAN
 SHARON H. KENNEDY, REGISTER OF DEEDS

BOOK 11 PAGE 16

Register of Deeds Stamp & File Number

I, Keith R. Waters, in a field survey on November 20, 1998, do hereby state that under requirements of P.A. 74, Michigan P.A. of 1970, the corner points mentioned in lines 1 and 2 above were in conformance with regulations and rules therefore as required in the current manual of survey instructions of the United States Department of the Interior, Bureau of Land Management or by a decree of a Court of Law and /or that the corner points mentioned in lines 3, 4 and 5 above were in conformance with the rules of the Michigan Board of Land Surveyors or by a Decree of a Court of Law; established, re-established, monumented, recovered, found as expressed below:

NOTE: Not more than 2 corners, all in the same town and range, may be recorded on this certificate.

A. Description of original monument and accessories and/or subsequent restoration:

E-12 1/4 Corner Common to Sections 32 & 33, T44N, R2W

1845 - Original corner established by James Mullett.

Witnesses: Fir 8, S48°E 05 links - Fir 10, S30°W 12 links.

1915 - Chippewa County Surveyor Frederick H. Brown, RLS 944, sketch of Section 33 shows this corner midway between section corners 2640 feet north and 2640 feet south.

1991 - LCRC, liber 7, page 333, Chippewa County corner records. Keith R. Waters, P.S. 33142, reestablished corner midway on line between section corners north and south. Set 1/2" iron with cap #33142. Witnesses:

14" Spruce, S47°W 64.78'

Power Pole (PD4/151/51), S10°E 123.10'

Power Pole (PD4/151/50), N25°E 57.10'

Telephone Pole, N06°W 120.10'

(Corner is 33' east of centerline of Centerline Road)

B. Description of corner evidence found and/or method applied in restoring or reestablishing corner:

This corner is being perpetuated as part of the Chippewa County Remonumentation Program.

Found a 1/2" iron with cap #33142 and three of the record witness objects from the above mentioned 1991 LCRC.

C. Description of monument for corner and accessories established to perpetuate locating the position of the corner:

Found a 1/2" iron with cap #33142 at the corner location, which falls 33 feet east of the centerline of Centerline Road. Witnesses:



Nail and witness tag in side of Power Pole (RU2/24B/50), N30°E 57.10'

Nail and witness tag in side of Power Pole, N62°W 107.15'

Nail and witness tag in side of 14" Spruce, S44°W 64.68'

Nail and witness tag in side of Power Pole (RU2/24B/51), S10°E 123.37'

1/2" Iron, WEST 65.98'

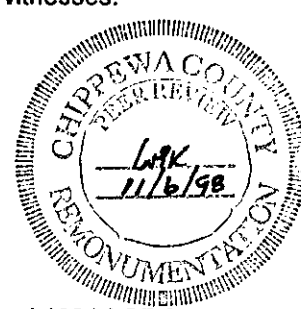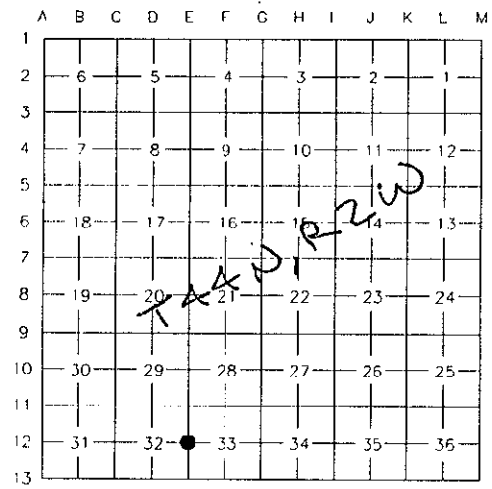

Signed by Keith R. Waters

Date 12-30-98

Surveyor's Michigan License No. 33142