

MAR 18 1999

LAND CORNER RECORDATION CERTIFICATE
Filing Requirement of Act 74, Mich. P.A. 1970
 Chippewa County Remonumentation Corner

SECTION

For corners in

Chippewa County	Located in:	Corner Code #
1. Public Land Survey	T44N R2W	F-9
	T R	
	T R	
	T R	
2. Property Controlling in Section	S T R	
	S T R	
3. Miscellaneous Property in Sec.	S T R	
	S T R	
4. Lot No. , Recorded Plat		
5. Private Claims		


\$7.00 LAND CORNER
 \$2.00 MSSR
 5 MAR 1999 2:05:06 PM Receipt #14029
 RECEIVED FOR RECORD
 CHIPPEWA COUNTY - STATE OF MICHIGAN
 SHARON H. KENNEDY, REGISTER OF DEEDS

BOOK 11 PAGE 19

Register of Deeds Stamp & File Number

I, Keith R. Waters, in a field survey on November 13, 1998, do hereby state that under requirements of P.A. 74, Michigan P.A. of 1970, the corner points mentioned in lines 1 and 2 above were in conformance with regulations and rules therefore as required in the current manual of survey instructions of the United States Department of the Interior, Bureau of Land Management or by a decree of a Court of Law and /or that the corner points mentioned in lines 3, 4 and 5 above were in conformance with the rules of the Michigan Board of Land Surveyors or by a Decree of a Court of Law; established, re-established, monumented, recovered, found as expressed below:

NOTE: Not more than 2 corners, all in the same town and range, may be recorded on this certificate.

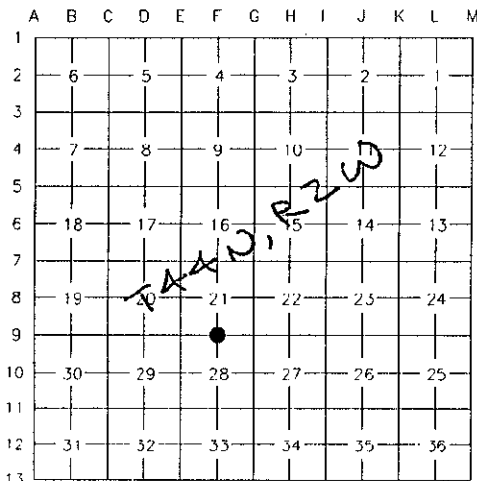

A. Description of original monument and accessories and/or subsequent restoration:

F-9 1/4 Corner Common to Sections 21 & 28, T44N, R2W

1845 - Original corner (8" Tamarack) established by James Mullett.

1905 - Chippewa County Surveyor Frederick H. Brown, RLS 944, sketch of Section 28 shows this corner midway between section corners 2636 feet east and 2636 feet west.

B. Description of corner evidence found and/or method applied in restoring or reestablishing corner:

This corner is being reestablished as part of the Chippewa County Remonumentation Program. Reestablished corner by single proportionate measurement midway on line between section corners at E-9 2636.4 feet west and at G-9 2636.4 feet east.



C. Description of monument for corner and accessories established to perpetuate locating the position of the corner:

Placed a 3/4" x 24" rebar with a stamped aluminum Chippewa County Remonumentation cap at the corner location, which falls in the median of Highway I-75, 34.15 feet east of the centerline of the southbound lanes, directly under the centerline of M-48 overpass. Witnesses:

- Chiseled "+" on southwest bolt of southerly end of center overpass support, S41°E 19.80'
- Chiseled "+" on northwest bolt of northerly end of center overpass support, N41°W 19.92'
- Chiseled "+" on southeast bolt of southerly end of westerly overpass support, S76°W 59.88'
- Chiseled "+" on northeast bolt of northerly end of westerly overpass support, N76°W 59.87'



Signed by Keith R. Waters

Date 12-30-98

Surveyor's Michigan License No. 33142