

SURVEY & REMONUMENTATION

CHIPPEWA COUNTY REMONUMENTATION CORNER

APR 26 1995

LAND CORNER RECORDATION CERTIFICATE

Filing Requirement of Act 74, Mich. P.A. 1970

COMMISSION

For corners in Chippewa

(County) _____ Located In: _____ Corner Code: # _____


1. Public Land Survey T 44N R 2W G-1
 T _____ R _____
 T _____ R _____
 T _____ R _____

2. Property Controlling in Section S _____ T _____ R _____
 S _____ T _____ R _____

3. Miscellaneous Property in Sec. S _____ T _____
 S _____ T _____

4. Lot No. _____, Recorded Plat _____

5. Private Claims _____

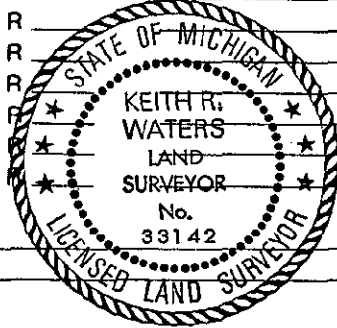

\$ 7.00 LAND CORNER
 \$ 2.00 HSSR
 19 JAN 95 4:20 P.M. RECEIPT# 2266
 RECEIVED FOR RECORD
 CHIPPEWA COUNTY - STATE OF MICHIGAN
 SHARON H. KENNEDY, REGISTER OF DEEDS

Register of Deeds Stamp & File Number

	A	B	C	D	E	F	G	H	I	J	K	L	M
2	6		5		4		3		2		1		
3													
4	7		8		9		10		11		12		
5													
6	18		17		16		15		14		13		
7													
8	19		20		21		22		23		24		
9													
10	30		29		28		27		26		25		
11													
12	31		32		33		34		35		36		
13													

I, Keith R. Waters, in a field survey on November 18, 1994, do hereby certify that under requirements of P.A. 74, Michigan P.A. of 1970, the corner points mentioned in lines 1 and 2 above were in conformance with regulations and rules therefore as required in the current manual of survey instructions of the United States Department of the Interior, Bureau of Land Management or by a decree of a Court of Law and/or that the corner points mentioned in lines 3, 4 and 5 above were in conformance with the rules of the Michigan Board of Land Surveyors or by a Decree of a Court of Law: established, re-established, monumented, re-monumented, recovered, found as expressed below:


NOTE: Not more than 4 corners, all in the same town and range, may be recorded on this certificate.

A. Description of original monument and accessories and/or subsequent restoration:

G-1 Corner Common to Sections 3 & 4, on the North Boundary of T44N, R2W. (Closing Corner on Township Line)
 Original ties to post: Spruce 12, S60°W 50 links Spruce 6, S43°E 20 links.
 1959 - Highway Department, as recorded in liber 2, page 235, liber 2, page 238, and liber 3, page 229, Chippewa County corner records. Corner is called out as a 1" iron bolt, a 1" iron pin, and a 1" iron bolt, respectively. Various fence posts and utility poles as shown as witnesses. It does not appear that double corners were recognized.
 1988 - Corner is shown on a certificate of survey by Larry Rogers, P.S. 29251.

B. Description of corner evidence found and/or method applied in restoring or reestablishing corner:

G-1 (T44N, R2W)
 This corner is being perpetuated as part of the Chippewa County Remonumentation Program.
 Found a 1" iron bolt as called for in previous Highway Department records and as shown on above mentioned certificate of survey. Position works well with other corners and occupation on township line east and west, and is on the approximate centerline of the extension of a road to the south. Corner falls inside the right-of-way fence on the east side of Highway I-75.
 Accepted corner as found and established new witness objects.

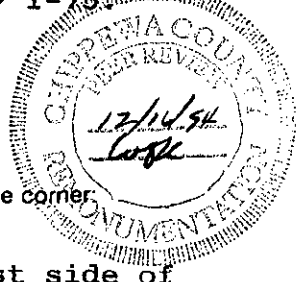

C. Description of monument for corner and accessories established to perpetuate locating the position of the corner:

G-1 (T44N, R2W)
 Corner is 1" iron bolt inside the right-of-way fence on the east side of Highway I-75. Witnesses:
 Power Pole, S34°W 297.91'
 Fence Post, N54°E 56.97'
 Fence Post, S28°W 89.84'
 Power Pole, N84°E 274.20'
 3/4" Rebar w/aluminum cap @ Standard Corner, WEST 13.20'

Note: Distances to poles and fence posts are to a nail and tag in the side. Bearings are compass bearings corrected for declination.

Signed by Keith R. Waters Date 12-23-94
 Surveyor's Michigan License No. 33142