

1999

SECTION

LAND CORNER RECORDATION CERTIFICATE
Filing Requirement of Act 74, Mich. P.A. 1970
Chippewa County Remonumentation Corner

For corners in

- Chippewa County Located in: Corner Code #
1. Public Land Survey T44N R2W G-5
2. Property Controlling in Section S T R
3. Miscellaneous Property in Sec. S T R
4. Lot No. , Recorded Plat
5. Private Claims

\$7.00 LAND CORNER
\$2.00 MSSR
5 MAR 1999 2:08:14 PM Receipt #14029
RECEIVED FOR RECORD
CHIPPEWA COUNTY - STATE OF MICHIGAN
SHARON H. KENNEDY, REGISTER OF DEEDS

BOOK 11 PAGE 24

Register of Deeds Stamp & File Number

I, Keith R. Waters, in a field survey on November 12, 1998, do hereby state that under requirements of P.A. 74, Michigan P.A. of 1970, the corner points mentioned in lines 1 and 2 above were in conformance with regulations and rules therefore as required in the current manual of survey instructions of the United States Department of the Interior, Bureau of Land Management or by a decree of a Court of Law and/or that the corner points mentioned in lines 3, 4 and 5 above were in conformance with the rules of the Michigan Board of Land Surveyors or by a Decree of a Court of Law; established, re-established, monumented, recovered, found as expressed below:

NOTE: Not more than 2 corners, all in the same town and range, may be recorded on this certificate.

A. Description of original monument and accessories and/or subsequent restoration:

G-5 Corner Common to Sections 9, 10, 15, & 16, T44N, R2W

- 1845 - Original corner established by James Mullett. Witnesses: Spruce 10, S67°E 33 links - Spruce 12, N67°W 34 links.
1897 - Chippewa County Surveyor Frederick H. Brown, RLS 944, notes indicate an iron post at this corner by Chamberlain of Mackinac County.
1959 - Liber 2, page 257, Chippewa County corner records. Michigan State Highway Department surveyor Ray Walker, this corner is a 1" iron pipe driven along side wood post. Witnesses: Telephone Pole, S55°E 52.43' - Fence Post, N55°E 39.51' - Fence Post, S60°W 46.25'.
1973 - Certificate of Survey, liber 1 of surveys, page 47. William H. Riipi Jr., RLS 19842, shows corner as a found 1" iron pin on side of cedar post.



B. Description of corner evidence found and/or method applied in restoring or reestablishing corner:

This corner is being perpetuated as part of the Chippewa County Remonumentation Program. Found a badly bent 1" iron pin next to remains of a rotted wooden post at the intersection of road centerlines north south, and east. All previous witness objects are gone. Replaced the bent pipe with a 3/4" x 24" rebar and plastic Chippewa County Remonumentation cap.

C. Description of monument for corner and accessories established to perpetuate locating the position of the corner:

Replaced a found bent 1" iron pipe with a 3/4" x 24" rebar and a plastic Chippewa County Remonumentation cap at the corner location, which falls in the centerline intersection of Hantz Road and 20 Mile Road. Witnesses:

- Nail and plastic witness tag #33142 in side of Power Pole, N28°E 101.07'
Nail and plastic witness tag #33142 in side of Power Pole, S06°E 264.72'
Nail and plastic witness tag #33142 in side of Fence Post, N28°W 72.74'
Nail and plastic witness tag #33142 in side of Fence Post, S65°W 80.56'

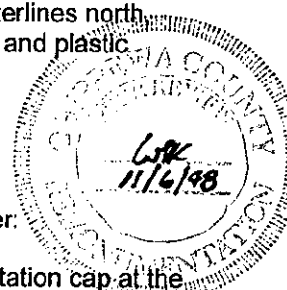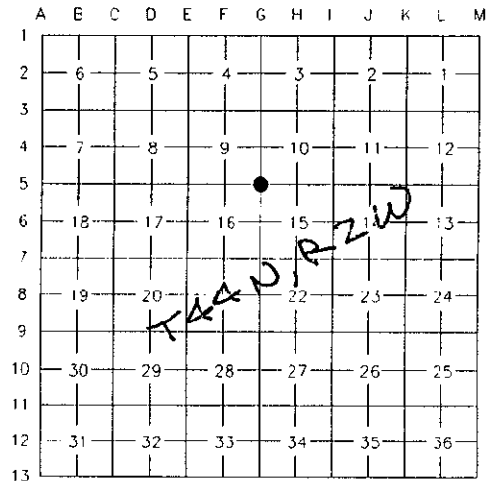

Signed by Keith R. Waters

Date 12-30-98

Surveyor's Michigan License No. 33142