

MAR 10 1999

LAND CORNER RECORDATION CERTIFICATE
Filing Requirement of Act 74, Mich. P.A. 1970
Chippewa County Remonumentation Corner


For corners in SECTION

Chippewa County	Located in:	Corner Code #
1. Public Land Survey	T44N R2W	G-8
	T R	
	T R	
	T R	
2. Property Controlling in Section	S T R	
	S T R	
3. Miscellaneous Property in Sec.	S T R	
	S T R	
4. Lot No.	, Recorded Plat	
5. Private Claims		

\$7.00 LAND CORNER
 \$2.00 MSSR
 5 MAR 1999 2:10:30 PM Receipt #14029
 RECEIVED FOR RECORD
 CHIPPWEA COUNTY - STATE OF MICHIGAN
 SHARON H. KENNEDY, REGISTER OF DEEDS

BOOK 11 PAGE 27
 Register of Deeds Stamp & File Number

I, Keith R. Waters, in a field survey on November 9, 1998, do hereby state that under requirements of P.A. 74, Michigan P.A. of 1970, the corner points mentioned in lines 1 and 2 above were in conformance with regulations and rules therefore as required in the current manual of survey instructions of the United States Department of the Interior, Bureau of Land Management or by a decree of a Court of Law and /or that the corner points mentioned in lines 3, 4 and 5 above were in conformance with the rules of the Michigan Board of Land Surveyors or by a Decree of a Court of Law; established, re-established, monumented, recovered, found as expressed below:

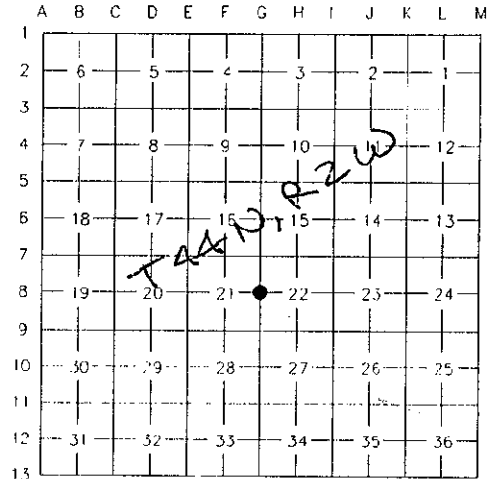


NOTE: Not more than 2 corners, all in the same town and range, may be recorded on this certificate.

A. Description of original monument and accessories and/or subsequent restoration:

G-8 1/4 Corner Common to Sections 21 & 22, T44N, R2W

- 1845 - Original corner established by James Mullett.
 Witnesses: Spruce 8, N45°W 08 links - Birch 10, S60°E 13 links.
- 1915 - Chippewa County Surveyor Frederick H. Brown, RLS 944, notes for Section 22 show the west line with a distance of 2624 feet for the north 1/2 mile and 2633 feet for the south 1/2 mile.

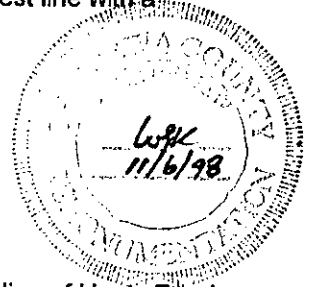

B. Description of corner evidence found and/or method applied in restoring or reestablishing corner:

This corner is being perpetuated as part of the Chippewa County Remonumentation Program. Found a 3/4" rebar with a plastic Chippewa County Remonumentation cap, 9 feet west of the centerline of Hantz Road. Found corner is on line between section corner G-7 2621.95 feet to the north and section corner G-9 2630.95 feet to the south, which is a proration of the above mentioned 1915 County Surveyor distance. Accepted corner as found.

C. Description of monument for corner and accessories established to perpetuate locating the position of the corner:

Found a 3/4" x 24" rebar with a plastic Chippewa County Remonumentation cap at the corner location, which falls 9 feet west of the centerline of Hantz Road. Witnesses:

- Nail and plastic witness tag #33142 in side of Power Pole, S14°W 147.17'
- Nail and plastic witness tag #33142 in side of Power Pole, N06°E 555.06'
- Nail and plastic witness tag #33142 in side of Power Pole (REA/A8), N05°W 252.24'
- "V" Notch in Culvert, N38°W 31.02'
- "V" Notch in Culvert, S72°W 22.04'
- 1/2" Iron, N45°E 45.00'
- 1/2" Iron, S45°E 45.00'



Signed by Keith R. Waters

Date 12-30-98

Surveyor's Michigan License No. 33142