

1899

SECTION

LAND CORNER RECORDATION CERTIFICATE
Filing Requirement of Act 74, Mich. P.A. 1970
Chippewa County Remonumentation Corner

For corners in

Table with columns: Chippewa County, Located in:, Corner Code #. Rows include Public Land Survey, Property Controlling in Section, Miscellaneous Property in Sec., Lot No., and Private Claims.

\$7.00 LAND CORNER
\$2.00 MSSR
5 MAR 1999 2:14:35 PM Receipt #14029
RECEIVED FOR RECORD
CHIPPewa COUNTY - STATE OF MICHIGAN
SHARON H. KENNEDY, REGISTER OF DEEDS

BOOK 11 PAGE 29
Register of Deeds Stamp & File Number

I, Keith R. Waters, in a field survey on November 13, 1998, do hereby state that under requirements of P.A. 74, Michigan P.A. of 1970, the corner points mentioned in lines 1 and 2 above were in conformance with regulations and rules therefore as required in the current manual of survey instructions of the United States Department of the Interior, Bureau of Land Management or by a decree of a Court of Law and /or that the corner points mentioned in lines 3, 4 and 5 above were in conformance with the rules of the Michigan Board of Land Surveyors or by a Decree of a Court of Law; established, re-established, monumented, recovered, found as expressed below:

NOTE: Not more than 2 corners, all in the same town and range, may be recorded on this certificate.

A. Description of original monument and accessories and/or subsequent restoration:

G-10 1/4 Corner Common to Sections 27 & 28, T44N, R2W

- 1845 - Original corner (12" Fir) established by James Mullett.
1905 - Chippewa County Surveyor Frederick H. Brown, RLS 944, notes for Section 28 show distances on the east line of 2639 feet for the north 1/2 mile and 2638 feet for the south 1/2 mile.
1915 - Brown's notes for Section 27 show distances on the west line of 2639 feet for the north 1/2 mile and 2637 feet for the south 1/2 mile.


B. Description of corner evidence found and/or method applied in restoring or reestablishing corner:

This corner is being reestablished as part of the Chippewa County Remonumentation Program. Found no evidence of the original corner. Reestablished corner on line between section corner G-9 to the north and section corner G-11 to the south at the proportionate distance according to the above mentioned 1915 County Surveyor notes. This position falls on the extension of the remains of a very old fence line to the east.

C. Description of monument for corner and accessories established to perpetuate locating the position of the corner:

Placed a 3/4" x 24" rebar with a plastic Chippewa County Remonumentation cap at the corner location, which falls in the approximate centerline of Hantz Road, under an east-west power line and on the on the extension of an old fence line to the east. Witnesses:

- Nail and plastic witness tag #33142 in side of Power Pole (36), S89°E 40.20'
Nail and plastic witness tag #33142 in side of blazed 8" Spruce, S88°W 92.14'
"V" notch in the top of the north end of a 15" CMP Culvert, S18°W 84.55'
"V" notch in the top of the east end of a 18" CMP Culvert, S10°E 122.56'

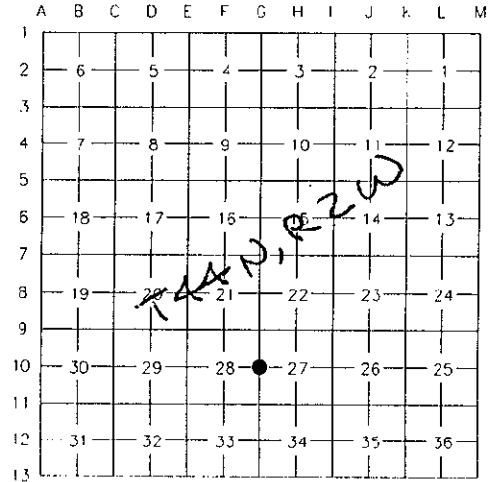

Signed by Keith R. Waters

Date 12-30-98

Surveyor's Michigan License No. 33142