

MAR 13 1999

**LAND CORNER RECORDATION CERTIFICATE**  
**Filing Requirement of Act 74, Mich. P.A. 1970**  
 Chippewa County Remonumentation Corner

For corners in SECTION

Chippewa County	Located in:	Corner Code #
1. Public Land Survey	T44N R2W	G-12
	T R	
	T R	
2. Property Controlling in Section	S T R	
	S T R	
3. Miscellaneous Property in Sec.	S T R	
	S T R	
4. Lot No. , Recorded Plat		
5. Private Claims		

\$7.00 LAND CORNER  
 \$2.00 MSSR  
 5 MAR 1999 2:15:57 PM Receipt #14029  
 RECEIVED FOR RECORD  
 CHIPPEWA COUNTY - STATE OF MICHIGAN  
 SHARON H. KENNEDY, REGISTER OF DEEDS

BOOK 11 PAGE 31  
 Register of Deeds Stamp & File Number

I, Keith R. Waters, in a field survey on December 18, 1998, do hereby state that under requirements of P.A. 74, Michigan P.A. of 1970, the corner points mentioned in lines 1 and 2 above were in conformance with regulations and rules therefore as required in the current manual of survey instructions of the United States Department of the Interior, Bureau of Land Management or by a decree of a Court of Law and /or that the corner points mentioned in lines 3, 4 and 5 above were in conformance with the rules of the Michigan Board of Land Surveyors or by a Decree of a Court of Law; established, re-established, monumented, recovered, found as expressed below:

NOTE: Not more than 2 corners, all in the same town and range, may be recorded on this certificate.

A	B	C	D	E	F	G	H	I	J	K	L	M
1												
2	6	5	4	3	2	1						
3												
4	7	8	9	10	11	12						
5												
6	18	17	16	15	14	13						
7												
8	19	20	21	22	23	24						
9												
10	30	29	28	27	26	25						
11												
12	31	32	33	34	35	36						
13												

*K.A.A. R2W*

A. Description of original monument and accessories and/or subsequent restoration:


G-12 1/4 Corner Common to Sections 33 & 34, T44N, R2W

1845 - Original corner (4" Cedar) established by James Mullett.

1916 - Chippewa County Surveyor Frederick H. Brown, RLS 944, notes for Section 34 appear to indicate that he reestablished this 1/4 corner was 2640 feet south of the section corner G-10 to the north.

B. Description of corner evidence found and/or method applied in restoring or reestablishing corner:

This corner is being perpetuated as part of the Chippewa County Remonumentation Program. Found a 3" diameter iron pipe, 2639.4 feet south of the section corner to the north at G-11. Found corner is 2661.1 feet north of the section corner G-13 on the township line to the south, and is 12 feet east of a straight line between said section corners. Section corner G-13 was reestablished in 1971 by single proportionate measurement on the township line. Based on the above mentioned 1916 County Surveyor notes, it appears as if Brown reestablished the 1/4 corner at record GLO distance south of the section corner G-11. I believe that the found pipe is probably a perpetuation of the corner as reestablished by Brown, and am accepting it as found.

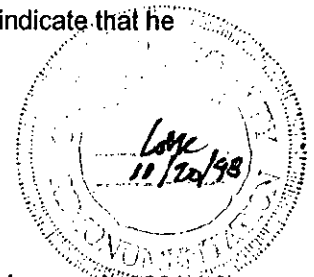

C. Description of monument for corner and accessories established to perpetuate locating the position of the corner:

Found a 3" o.d. iron pipe 6" above ground at the corner location. Witnesses:

- Nail and plastic witness tag #33142 in side of blazed 9" Tamarack, S32°E 94.15'
- Nail and plastic witness tag #33142 in side of blazed 8" Poplar, N55°W 6.99'
- Nail and plastic witness tag #33142 in side of blazed 4" Poplar, S35°W 12.51'
- Nail and plastic witness tag #33142 in side of blazed 6" Spruce, S78°E 80.60'



Signed by Keith R. Waters

Date 12-30-98

Surveyor's Michigan License No. 33142