

SURVEY & REMONUMENTATION

APR 26 1995

CHIPPEWA COUNTY REMONUMENTATION CORNER

COMMISSION

LAND CORNER RECORDATION CERTIFICATE

Filing Requirement of Act 74, Mich. P.A. 1970

For corners in Chippewa

(County)

Located In:

Corner Code #

1. Public Land Survey	T 44N R 2W	H-1
	T _____ R _____	_____
	T _____ R _____	_____
	T _____ R _____	_____
2. Property Controlling in Section	S _____ T _____ R _____	_____
	S _____ T _____ R _____	_____
3. Miscellaneous Property in Sec.	S _____ T _____ R _____	_____
	S _____ T _____ R _____	_____

\$ 7.00 LAND CORNER
 \$ 2.00 MSSR
 5 DEC 94 12:29 P.M. RECEIPT# 1519
 RECEIVED FOR RECORD
 CHIPPEWA COUNTY - STATE OF MICHIGAN
 SHARON H. KENNEDY, REGISTER OF DEEDS

Register of Deeds Stamp & File Number

4. Lot No. _____, Recorded Plat _____
 5. Private Claims _____

I, Keith R. Waters in a field survey on January 4, 19 94

do hereby certify that under requirements of P.A. 74, Michigan P.A. of 1970, the corner points mentioned in lines 1 and 2 above were in conformance with regulations and rules therefore as required in the current manual of survey instructions of the United States Department of the Interior, Bureau of Land Management or by a decree of a Court of Law and/or that the corner points mentioned in lines 3, 4 and 5 above were in conformance with the rules of the Michigan Board of Land Surveyors or by a Decree of a Court of Law; established, re-established, monumented, re-monumented, recovered, found as expressed below:

NOTE: Not more than 4 corners, all in the same town and range, may be recorded on this certificate.

A. Description of original monument and accessories and/or subsequent restoration:

H-1 North 1/4 Corner of Section 3, T44N, R2W

Corner was not set in original survey.

B. Description of corner evidence found and/or method applied in restoring or reestablishing corner:

H-1 (T44N, R2W)

This corner is being established as part of the Chippewa County Remonumentation Program.

Found no evidence of corner. Set corner on township line midway between closing Section corners 2647.08 feet east and 2647.08 feet west. Corner falls 1.5 feet south of the centerline of east-west asphalt road (Kallio Road)

C. Description of monument for corner and accessories established to perpetuate locating the position of the corner:


H-1 (T44N, R2W)

Corner is a 3/4" x 24" rebar with plastic Chippewa County Remonumentation cap 1.5 feet south of the centerline of Kallio Road. Witnesses:

- 7" Tamarack, S18°E 45.76'
- 7" Spruce, N23°E 77.67'
- 7" Balsam Fir, N02°W 76.52'
- Power Pole (RU2-96A-10), N62°W 116.47'

Note: Distances are to a nail and tag in the side of the witness object. Trees are blazed and painted. Bearings are compass bearings corrected for declination. Distances are measured with EDM.

	A	B	C	D	E	F	G	H	I	J	K	L	M
2	6	5	4	3	2	1							
3													
4	7	8	9	10	11	12							
5													
6	18	17	16	15	14	13							
7													
8	19	20	21	22	23	24							
9													
10	30	29	28	27	26	25							
11													
12	31	32	33	34	35	36							
13													

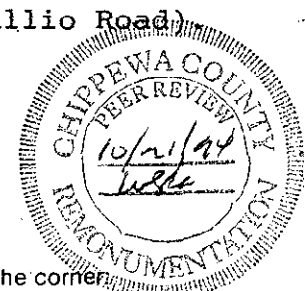

Signed by Keith R. Waters
 Surveyor's Michigan License No. 33142

Date 10-25-94