

**SURVEY & REMONUMENTATION**

APR 26 1995

CHIPPEWA COUNTY REMONUMENTATION CORNER


COMMISSION

LAND CORNER RECORDATION CERTIFICATE

Filing Requirement of Act 74, Mich. P.A. 1970

For corners in Chippewa

	(County)	Located In:	Corner Code #
1. Public Land Survey	T 44N R 2W	I-1	
	T _____ R _____		
	T _____ R _____		
	T _____ R _____		
2. Property Controlling in Section	S _____ T _____ R _____		
3. Miscellaneous Property in Sec.	S _____ T _____ R _____		
4. Lot No. _____, Recorded Plat _____			
5. Private Claims _____			

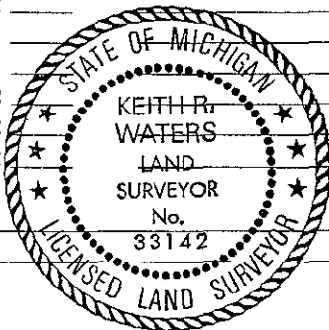

\$ 7.00 LAND CORNER  
 \$ 2.00 MSSR  
 5 DEC 94 12:29 P.M. RECEIPT# 1519  
 RECEIVED FOR RECORD  
 CHIPPEWA COUNTY - STATE OF MICHIGAN  
 SHARON H. KENNEDY, REGISTER OF DEEDS  
 Register of Deeds Stamp & File Number


	A	B	C	D	E	F	G	H	I	J	K	L	M
2	6	5	4	3	2	1							
3													
4	7	8	9	10	11	12							
5													
6	18	17	16	15	14	13							
7													
8	19	20	21	22	23	24							
9													
10	30	29	28	27	26	25							
11													
12	31	32	33	34	35	36							
13													

Keith R. Waters in a field survey on January 4, 19 94  
 do hereby certify that under requirements of P.A. 74, Michigan P.A. of 1970, the corner points mentioned in lines 1 and 2 above were in conformance with regulations and rules therefore as required in the current manual of survey instructions of the United States Department of the Interior, Bureau of Land Management or by a decree of a Court of Law and/or that the corner points mentioned in lines 3, 4 and 5 above were in conformance with the rules of the Michigan Board of Land Surveyors or by a Decree of a Court of Law; established, re-established, monumented, re-monumented, recovered, found as expressed below:

**NOTE: Not more than 4 corners, all in the same town and range, may be recorded on this certificate.**

A. Description of original monument and accessories and/or subsequent restoration:

I-1 Corner Common to Sections 2 & 3, on North Boundary of T44N, R2W  
 (Closing Corner on Township Line)  
 Original ties to post: Spruce 8, S75°W 35 links  
 Fir 10, S68°E 10 links  
 1991 - Corner is shown on a survey drawing by Ronald R. Bischer, P.S. 22428, as a 1/2" rod 32.34 feet east of a found 1" pipe at standard corner.  
 Witnesses: 8" Spruce, N16°E 28.4' 6" Spruce, S54°E 33.9'  
 18" Spruce, S56°W 18.8'

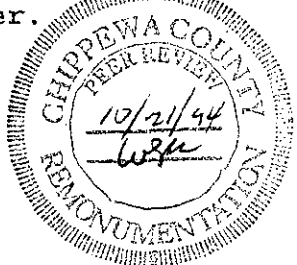

B. Description of corner evidence found and/or method applied in restoring or reestablishing corner:

I-1 (T44N, R2W)  
 This corner is being perpetuated as part of the Chippewa County Remonumentation Program.  
 In 1991 I found a 1/2" iron with cap #22428 with all record witness objects intact. Iron and all but one witness object have since been destroyed by road construction. Set a new 3/4" rebar and 3/4" aluminum Chippewa County Remonumentation cap in same location using traverse information from survey work which I did in 1991. Corner falls approximately 5 feet east of the centerline of a north-south dirt road, and approximately 100 feet south of the centerline of east-west County Road (Aho Road).

C. Description of monument for corner and accessories established to perpetuate locating the position of the corner:

I-1 (T44N, R2W)  
 Corner is a 3/4" x 24" rebar with 3/4" aluminum Chippewa County Remonumentation cap. Witnesses:  
 30" White Pine, N30°E 42.35'  
 Power Pole, N03°E 120.80'  
 8" Spruce, S52°E 33.78'  
 Power Pole (RU2-96A-17), N68°W 103.66'

Note: Distances are to a nail and tag in the side of the witness object. Trees are blazed and painted. Bearings are compass bearings corrected for declination. Distances are measured with EDM.

Signed by Keith R. Waters Date 10-25-94  
 Surveyor's Michigan License No. 33142