

SURVEY & REMONUMENTATION

APR 26 1995

CHIPPEWA COUNTY REMONUMENTATION CORNER

COMMISSION

LAND CORNER RECORDATION CERTIFICATE

Filing Requirement of Act 74, Mich. P.A. 1970

For corners in Chippewa

(County)

Located In:

Corner Code #

- | | | |
|---------------------------------------|--------------------------|-------|
| 1. Public Land Survey | T <u>44N</u> R <u>2W</u> | I-2 |
| | T _____ R _____ | _____ |
| | T _____ R _____ | _____ |
| | T _____ R _____ | _____ |
| 2. Property Controlling in Section | S _____ T _____ R _____ | _____ |
| | S _____ T _____ R _____ | _____ |
| 3. Miscellaneous Property in Sec. | S _____ T _____ R _____ | _____ |
| | S _____ T _____ R _____ | _____ |
| 4. Lot No. _____, Recorded Plat _____ | | |
| 5. Private Claims _____ | | |

\$ 7.00 LAND CORNER
 \$ 2.00 MSSR
 5 DEC 94 12:28 P.M. RECEIPT# 1519
 RECEIVED FOR RECORD
 CHIPPEWA COUNTY - STATE OF MICHIGAN
 SHARON H. KENNEDY, REGISTER OF DEEDS

Register of Deeds Stamp & File Number

	A	B	C	D	E	F	G	H	I	J	K	L	M
2	6	5	4	3	2	1							
3													
4	7	8	9	10	11	12							
5													
6	18	17	16	15	14	13							
7													
8	19	20	21	22	23	24							
9													
10	30	29	28	27	26	25							
11													
12	31	32	33	34	35	36							
13													

I, Keith R. Waters in a field survey on January 4, 1994, do hereby certify that under requirements of P.A. 74, Michigan P.A. of 1970, the corner points mentioned in lines 1 and 2 above were in conformance with regulations and rules therefore as required in the current manual of survey instructions of the United States Department of the Interior, Bureau of Land Management or by a decree of a Court of Law and/or that the corner points mentioned in lines 3, 4 and 5 above were in conformance with the rules of the Michigan Board of Land Surveyors or by a Decree of a Court of Law; established, re-established, monumented, re-monumented, recovered, found as expressed below:

NOTE: Not more than 4 corners, all in the same town and range, may be recorded on this certificate.


A. Description of original monument and accessories and/or subsequent restoration:
 I-2 1/4 Corner Common to Sections 2 & 3, T44N, R2W

Original ties to post: Aspen 12, S32°E 12 links
 Aspen 10, N49°W 16 links



B. Description of corner evidence found and/or method applied in restoring or reestablishing corner:

I-2 (T44N, R2W)
 This corner is being re-established as part of the Chippewa County Remonumentation Program.
 Found no evidence of corner or its accessories. Re-established corner by single proportionate measurement with original GLO notes on line between Section corner 2642.21 feet south and closing Section corner 2619.10 feet north.

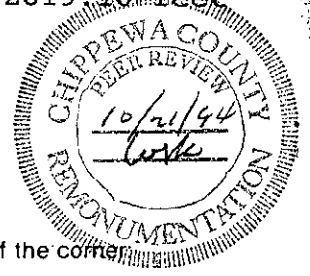

C. Description of monument for corner and accessories established to perpetuate locating the position of the corner:
 I-2 (T44N, R2W)
 Corner is a 3/4" x 24" rebar with 3/4" aluminum Chippewa County Remonumentation cap. Witnesses:

- 6" Spruce, N56°W 23.16'
- 6" Spruce, S42°W 12.33'
- 8" Spruce, S86°E 61.04'
- 5" Spruce, N15°E 53.54'

Note: Distances are to a nail and tag in the side of the witness object. Trees are blazed and painted. Bearings are compass bearings corrected for declination.

Signed by Keith R. Waters

Date 10-25-94

Surveyor's Michigan License No. 33142