SURVEY & REMONUMENTATION

APR 2 6 1995

COMMISSION

CHIPPEWA COUNTY REMONUMENTATION CORNER

LAND CORNER RECORDATION CERTIFICATE

Filing Requirement of Act 74, Mich. P.A. 1970

For corners in Chippewa (County)

	Located In:	Corner Code #
1. Public Land Survey	T 44N R 2W	K-1 Same
	T 45N R 2W	K-13 Corner
	T ___ R ___	
	T ___ R ___	
2. Property Controlling	S ___ T ___ R ___	
in Section	S ___ T ___ R ___	
3. Miscellaneous	S ___ T ___ R ___	
Property in Sec.	S ___ T ___ R ___	

4. Lot No. _____ , Recorded Plat _____
5. Private Claims _____

STATE OF MICHIGAN KEITH R. WATERS LAND SURVEYOR No. 33142 LICENSED LAND SURVEYOR

$ 7.00 LAND CORNER
$ 2.00 MSSR
19 JAN 95 4:19 P.M. RECEIPT# 2266
RECEIVED FOR RECORD
CHIPPEWA COUNTY - STATE OF MICHIGAN
SHARON H. KENNEDY, REGISTER OF DEEDS

Register of Deeds Stamp & File Number

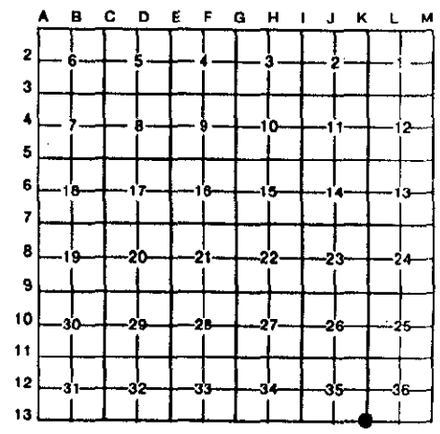

I, Keith R. Waters, in a field survey on December 12, 19 94, do hereby certify that under requirements of P.A. 74, Michigan P.A. of 1970, the corner points mentioned in lines 1 and 2 above were in conformance with regulations and rules therefore as required in the current manual of survey instructions of the United States Department of the Interior, Bureau of Land Management or by a decree of a Court of Law and/or that the corner points mentioned in lines 3, 4 and 5 above were in conformance with the rules of the Michigan Board of Land Surveyors or by a Decree of a Court of Law; established, re-established, monumented, re-monumented, recovered, found as expressed below:

NOTE: Not more than 4 corners, all in the same town and range, may be recorded on this certificate.

A. Description of original monument and accessories and/or subsequent restoration:

K-13 Corner Common to Secs. 1 & 2, T44N, R2W & Secs. 35 & 36, T45N, R2W.

Original ties to post: White Pine 10, S43°W 14 links Fir 7, N70°E 26 links
Spruce 6, S33°E 26 links Fir 7, N29°W 14 links

1991 - Corner is shown on a survey drawing by Ronald Bischer, P.S. 22428, as a found ½" pipe. Witnesses: 8" Spruce, S74°E 36.3' 4" Spruce, S52°W 35.1' Cedar Post, N35°W 35.7'.

B. Description of corner evidence found and/or method applied in restoring or reestablishing corner:

K-13 (T45N, R2W)
This corner is being perpetuated as part of the Chippewa County Remonumentation Program.
Found a ½" iron pipe on an east-west trail and witnesses as called for on above mentioned survey drawing. Position works well with other corners in the area. Accepted corner position as found, set a new 3/4" rebar with aluminum Chippewa County cap over pipe, and established additional witness objects.

C. Description of monument for corner and accessories established to perpetuate locating the position of the corner:

K-13 (T45N, R2W)
Corner is a 3/4" x 24" rebar with 3¼" aluminum Chippewa County Remonumentation cap on an east-west trail. Witnesses:

6" Spruce, S46°E 30.79'
11" Spruce, S74°E 36.29'
8" Spruce, S52°W 34.94'
11" Spruce, N25°W 68.74'

Note: Distances are to a nail and tag in the side of the tree. Trees are blazed and painted. Bearings are compass bearings corrected for declination.

Signed by Keith R. Waters Date 12-23-94

Surveyor's Michigan License No. 33142

CHIPPEWA COUNTY SURVEY REVIEW 12/16/94 REMONUMENTATION

FORM APPROVED BY MICHIGAN STATE BOARD OF LAND SURVEYORS, JAN. 28, 1971
REVISED MAY 14, 1975
REVISED JAN. 1983