

MAR 10 1999

SECTION

LAND CORNER RECORDATION CERTIFICATE
Filing Requirement of Act 74, Mich. P.A. 1970
Chippewa County Remonumentation Corner

For corners in

Chippewa County

Located in:

Corner Code #

1. Public Land Survey

T44N R2W

A-2

Same

T44N R3W

M-2

Corner

2. Property Controlling in Section

S

T T

R R

3. Miscellaneous Property in Sec.

S

T

R

4. Lot No.

, Recorded Plat

5. Private Claims



\$7.00 LAND CORNER

\$2.00 MSSR

5 MAR 1999 10:33:44 AM Receipt #14013

RECEIVED FOR RECORD

CHIPPEWA COUNTY - STATE OF MICHIGAN
SHARON H. KENNEDY, REGISTER OF DEEDS

BOOK 10 PAGE 381

Register of Deeds Stamp & File Number

I, Keith R. Waters, in a field survey on October 12, 1998, do hereby state that under requirements of P.A. 74, Michigan P.A. of 1970, the corner points mentioned in lines 1 and 2 above were in conformance with regulations and rules therefore as required in the current manual of survey instructions of the United States Department of the Interior, Bureau of Land Management or by a decree of a Court of Law and /or that the corner points mentioned in lines 3, 4 and 5 above were in conformance with the rules of the Michigan Board of Land Surveyors or by a Decree of a Court of Law; established, re-established, monumented, recovered, found as expressed below:

NOTE: Not more than 2 corners, all in the same town and range, may be recorded on this certificate.

A. Description of original monument and accessories and/or subsequent restoration:

A-2 1/4 Corner Common to Section 6, T44N, R2W & Section 1, T44N, R3W

1840 - Original corner established by William A. Burt.

Witnesses: Fir 10, N10°W (no distance shown) - Aspen 8, S48°W 14 links.

1896 - Chippewa County Surveyor Frederick H. Brown, RLS 944, notes for Section 6 indicate that "the outside of this section was established by Carleton when he surveyed the Village of Rudyard and I did not make any changes." His sketch shows distances of 2660 and 2785 on the south and north 1/2 miles respectively.

1991 - Sketch of subdivision of Section 6 by William L. Karr, P.S. 27450, indicates that the west 1/4 corner was computed by pro-rating the measured mile distance between A-1 and A-3 against the above mentioned County Surveyor distance.

B. Description of corner evidence found and/or method applied in restoring or reestablishing corner:

This corner is being reestablished as part of the Chippewa County Remonumentation Program.

Found no evidence of the original corner. Reestablished the corner by single proportionate measurement between recovered corners at A-1 and A-3, as shown on the above mentioned 1991 section subdivision sketch.

C. Description of monument for corner and accessories established to perpetuate locating the position of the corner:


Placed a 3/4" x 24" rebar with a stamped aluminum Chippewa County Remonumentation cap at the corner location, which falls on the top of the easterly bank of a ditch, 10'± west of the northerly extension of the west edge of a gravel road (Turner Road) to the south. Witnesses:

Nail and plastic witness tag #33142 in side of 18" Boxelder Maple (easterly tree in clump), N66°W 96.41'

Nail and plastic witness tag #33142 in side of Corner Fence Post (easterly end of gate), S28°W 60.42'

Nail and plastic witness tag #33142 in side of blazed 7" White Birch, N44°E 64.24'

Nail and plastic witness tag #33142 in side of blazed 6" Spruce, N20°W 70.84'

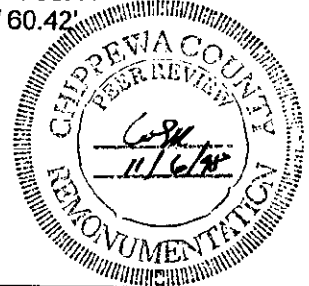

Signed by Keith R. Waters

Date 12-30-98

Surveyor's Michigan License No. 33142