

MAY 28 1997

COMMISSION CHIPPEWA COUNTY REMONUMENTATION CORNER

LAND CORNER RECORDATION CERTIFICATE
 Filing Requirement of Act 74, Mich. P.A. 1970

\$7.00 LAND CORNER

For corners in

Chippewa (County)	Located In:	Corner Code #
1. Public Land Survey	T44N R 5W	F-9
	T R	
	T R	
	T R	
2. Property Controlling in Section	S T R	
	S T R	
3. Miscellaneous Property in Sec.	S T R	
	S T R	

\$2.00 MSSR
 2/28/1997 4:00:01 PM Receipt #226
 RECEIVED FOR RECORD
 CHIPPEWA COUNTY - STATE OF MICHIGAN
 SHARON W. KENNEDY, REGISTER OF DEEDS
 BOOK 9 PAGE 385

Register of Deeds Stamp & File Number

4. Lot No. _____, Recorded Plat _____
 5. Private Claims _____

I, Keith R. Waters, in a field survey on 09/09, 1996 do hereby state that under requirements of P.A. 74, Michigan P.A. of 1970, the corner points mentioned in lines 1 and 2 above were in conformance with regulations and rules therefore as required in the current manual of survey instructions of the United States Department of the Interior, Bureau of Land Management or by a decree of a Court of Law and /or that the corner points mentioned in lines 3, 4 and 5 above were in conformance with the rules of the Michigan Board of Land Surveyors or by a Decree of a Court of Law; established, re-established, monumented, recovered, found as expressed below:

NOTE: Not more than 2 corners, all in the same town and range, may be recorded on this certificate.

	A	B	C	D	E	F	G	H	I	J	K	L	M
1													
2	6		5		4		3		2		1		
3													
4	7		8		9		10		11		12		
5													
6	18		17		16		15		14		13		
7													
8	19		20		21		22		23		24		
9													
10	30		29		28		27		26		25		
11													
12	31		32		33		34		35		36		
13													


A. Description of original monument and accessories and/or subsequent restoration:

F-9 1/4 Corner Common to Sections 21 & 28, Town 44 North, Range 5 West
 1849 - Original ties (Harvey Mullen): Sugar 18, S07°E 35 links - Yellow Birch 28, N13°W 38 links.
 1937 - United States Department of Interior, General Land Office, Dependent Resurvey, Oscar Walsh, surveyor.
 Re-established corner by proportionate measurement. Placed a 2" x 36" iron post at corner position.
 Witnesses: 14" Elm, S76°47'E 275 links - White painted stake 4" square, S31°17'W 44 links.



B. Description of corner evidence found and/or method applied in restoring or reestablishing corner:

This corner is being perpetuated as part of the Chippewa County Remonumentation Program.
 Found a brass capped GLO monument 11.2 feet north of the centerline of east-west asphalt road (H-40), approximately 2 feet west of the centerline of Lake Road to the south. Position fits well with recovered section corners east and west as shown in above mentioned dependent resurvey.

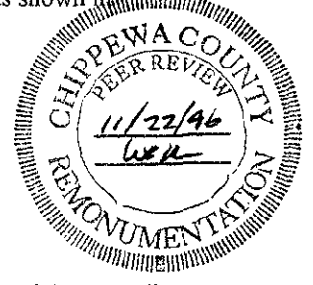

C. Description of monument for corner and accessories established to perpetuate locating the position of the corner:

Corner is a GLO monument with a brass tablet 11.2 feet north of the centerline of H-40, approximately 2 feet west of the centerline of Lake Road to the south. Monument is 20 inches below the gravel shoulder surface. Witnesses:
 8" Sugar Maple, N03°W 28.25'
 6" Sugar Maple, N37°E 31.53'
 18" Ash, S25°W 75.44'
 PK nail in the centerline of H-40, SOUTH 11.20'

Note: Unless noted otherwise, distances are to a nail/tag #33142 in the side of the witness object. Bearings are compass bearings corrected for declination. Maples are blazed and painted.

Signed by Keith R. Waters
 Surveyor's Michigan License No. 33142

Date 12-30-96