

1993

CHIPPEWA COUNTY REMONUMENTATION CORNER

RECEIVED FOR RECORD
CHIPPEWA COUNTY
STATE OF MICHIGAN

COMMISSION

LAND CORNER RECORDATION CERTIFICATE
Filing Requirement of Act 74, Mich. P.A. 1970

93 DEC -3 PM 3: 58

For corners in
Chippewa

(County)

Located in:

Corner Code #

1. Public Land Survey	T45N R 1E	<u>A-5</u> Same
	T45N R 1W	M-5 Corner
	T ___ R ___	_____
	T ___ R ___	_____
2. Property Controlling in Section	S ___ T ___ R ___	_____
	S ___ T ___ R ___	_____
3. Miscellaneous Property in Sec.	S ___ T ___ R ___	_____
	* S ___ T ___ R ___	_____

J. Roger Malott
REGISTER OF DEEDS

Register of Deeds Stamp & File Number

4. Lot No. _____, Recorded Plat _____
5. Private Claims _____

I, Keith R. Waters in a field survey on June 3, 19 93, do hereby certify that under requirements of P.A. 74, Michigan P.A. of 1970, the corner points mentioned in lines 1 and 2 above were in conformance with regulations and rules therefore as required in the current manual of survey instructions of the United States Department of the Interior, Bureau of Land Management or by a decree of a Court of Law and/or that the corner points mentioned in lines 3, 4 and 5 above were in conformance with the rules of the Michigan Board of Land Surveyors or by a Decree of a Court of Law; established, re-established, monumented, re-monumented, recovered, found as expressed below:

NOTE: Not more than 4 corners, all in the same town and range, may be recorded on this certificate.

A. Description of original monument and accessories and/or subsequent restoration:

A-5 (T45N, R1E)
Section Corner Common to Sections 7 & 18, T45N, R1E and Sections 12 & 13, T45N, R1W.
Michigan State Highway Department (11-29-65) as recorded in liber 2, page 244, shows corner as 1/2" rered in monument box. Also recorded by Thomas M. Kelly, R.L.S. 24599, in liber 1, page 343, Chippewa County corner records (1978) as a 1/2" iron in monument box with the following ties: Stop Sign, N60°E 59.10' Stop Sign, S65°W 51.00' MBT Pole (386), N50°W 78.30'

B. Description of corner evidence found and/or method applied in restoring or reestablishing corner:


A-5 (T45N, R1E)
This corner is being perpetuated as part of the Chippewa County Remonumentation Program.
Found a 1/2" iron pin in a monument box 1.3' west of centerline of Highway M-129 at the intersection of 14 Mile Road. All witnesses from Highway Department and Kelly records are gone. Accepted corner as found and established four new witness objects.

C. Description of monument for corner and accessories established to perpetuate locating the position of the corner:

A-5 (T45N, R1E)
Corner is a 1/2" iron pin in a monument box 1.3' west of centerline of Highway M-129 at the intersection of 14 Mile Road.

Witnesses:
P. Pole (DR2-119), N20°E 210.66'
14" Austrian Pine, S65°E 169.64'
4"x4" Cable Post, S63°W 105.83'
(Nail and tag in top)
7" Spruce, N43°W 66.57'

Note: Unless noted otherwise, distances are to a nail and tag in the side of witness object. Bearings are compass bearings corrected for declination. Distances measured with EDM. Trees are not blazed due to the proximity of houses.

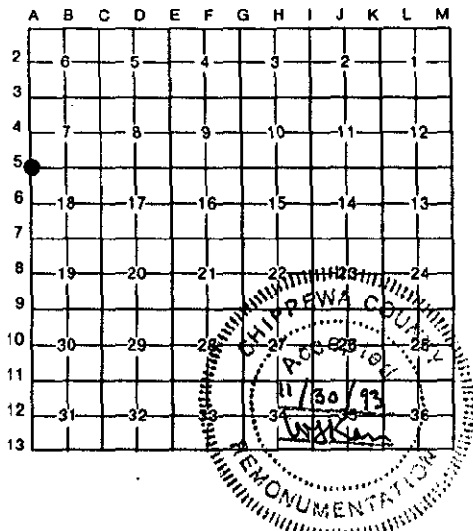

Signed by Keith R. Waters Date 11-30-93
Surveyor's Michigan License No. 33142