

1993

**CHIPPEWA COUNTY REMONUMENTATION CORNER
LAND CORNER RECORDATION CERTIFICATE
Filing Requirement of Act 74, Mich. P.A. 1970**

RECEIVED FOR RECORD
CHIPPEWA COUNTY
STATE OF MICHIGAN

COMMISSION

93 DEC -3 PM 3: 58


For corners in
Chippewa
(County)

Located In:	Corner Code #
T <u>45N</u> R <u>1E</u>	<u>A-9</u> Same
T <u>45N</u> R <u>1W</u>	<u>M-9</u> Corner
T _____ R _____	_____
T _____ R _____	_____
S _____ T _____ R _____	_____
S _____ T _____ R _____	_____
S _____ T _____ R _____	_____
-S _____ T _____ R _____	_____

J. Roger Malott
REGISTER OF DEEDS

Register of Deeds Stamp & File Number

4. Lot No. _____, Recorded Plat _____
5. Private Claims _____

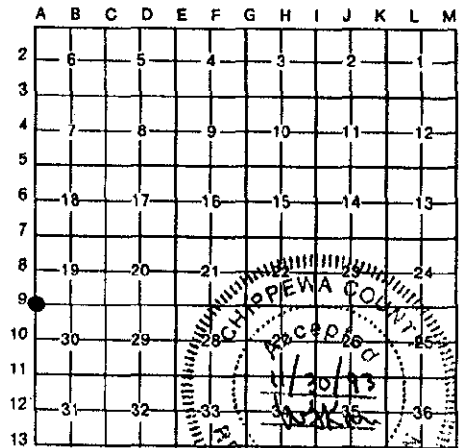

I, Keith R. Waters, in a field survey on July 29, 19 93, do hereby certify that under requirements of P.A. 74, Michigan P.A. of 1970, the corner points mentioned in lines 1 and 2 above were in conformance with regulations and rules therefore as required in the current manual of survey instructions of the United States Department of the Interior, Bureau of Land Management or by a decree of a Court of Law and/or that the corner points mentioned in lines 3, 4 and 5 above were in conformance with the rules of the Michigan Board of Land Surveyors or by a Decree of a Court of Law; established, re-established, monumented, re-monumented, recovered, found as expressed below:

NOTE: Not more than 4 corners, all in the same town and range, may be recorded on this certificate.


A. Description of original monument and accessories and/or subsequent restoration:

A-9 (T45N, R1E)
Section Corner Common to Sections 19 & 30, T45N, R1E and Sections 24 & 25, T45N, R1W).

Michigan State Highway Department (11-29-65) as recorded in liber 2, page 226, of Chippewa County corner records: Found 1" iron pin in monument box with the following ties: 12" Willow, S30°E 71.08' Mail Box, S45°W 33.52'
4" Pine, N55°W 74.83'

B. Description of corner evidence found and/or method applied in restoring or reestablishing corner:

A-9 (T45N, R1E)
This corner is being perpetuated as part of the Chippewa County Remonumentation Program.
Found a 1/2" iron pin in a monument box in the centerline of Highway M-129 at the intersection of 16 Mile Road. All witnesses from Highway Department records are gone. Distances to Section corner 1 mile north and to 1/4 corner 1/2 mile south check closely with those as shown on Highway Department records. Accepted corner as found and established four new witness objects.

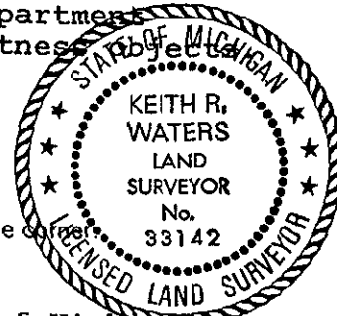

C. Description of monument for corner and accessories established to perpetuate locating the position of the corner:

A-9 (T45N, R1E)
Corner is a 1/2" iron pin in a monument box in the centerline of Highway M-129 at the intersection of 16 Mile Road. Witnesses:

- Power Pole, N26°E 200.10'
- Power Pole, S64°E 84.73'
- Nail and tag in top of Northerly Guard Rail Post, S09°E 122.28'
- Nail and tag in top of Northerly Guard Rail Post, S22°W 90.60'

Note: Unless noted otherwise, distances are to a nail and tag in the side of witness object. Bearings are compass bearings corrected for declination. Distances are measured with EDM.

Signed by Keith R. Waters Date 11-30-93

Surveyor's Michigan License No. 33142