

**SURVEY &
REMONUMENTATION**

APR 07 1998

Chippewa County Remonumentation Corner
LAND CORNER RECORDATION CERTIFICATE
Filing Requirement of Act 74, Mich. P.A. 1970

SECTION

For corners in

<u>Chippewa</u>	Located In:	Corner Code #
1. Public Land Survey	T <u>45N</u> R <u>1E</u>	<u>B-5</u>
	T ___ R ___	
	T ___ R ___	
	T ___ R ___	
2. Property Controlling in Section	S ___ T ___ R ___	
	S ___ T ___ R ___	
3. Miscellaneous Property in Sec.	S ___ T ___ R ___	
	S ___ T ___ R ___	

\$7.00 LAND CORNER
\$2.00 N SSR
14 Jan 1998 3:16:11 PM Receipt #5566
RECEIVED FOR RECORD
CHIPPEWA COUNTY - STATE OF MICHIGAN
SHARON H. KENNEDY, REGISTER OF DEEDS


BOOK 10 PAGE 110

Register of Deeds Stamp & File Number

4. Lot No. _____, Recorded Plat _____
5. Private Claims _____

I, Larry R. Rogers, in a field survey on October 22, 1997, do hereby state that under requirements of P.A. 74, Michigan P.A. of 1970, the corner points mentioned in lines 1 and 2 above were in conformance with regulations and rules therefore as required in the current manual of survey instructions of the United States Department of the Interior, Bureau of Land Management or by a decree of a Court of Law and/or that the corner points mentioned in lines 3, 4 and 5 above were in conformance with the rules of the Michigan Board of Land Surveyors or by a Decree of a Court of Law; established, re-established, monumented, recovered, found as expressed below:

NOTE: Not more than 2 corners, all in the same town and range, may be recorded on this certificate.

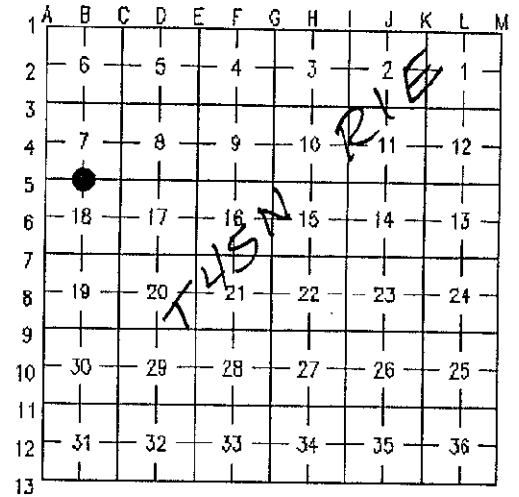

A. Description of original monument and accessories and/or subsequent restoration:

(B-5) 1/4 Corner Common to Sections 7 and 18, T.45 N., R.1 E.

Original corner post was placed in September, 1845 by James H. Mullett. County Surveyor Brown found original corner around 1900. In August, 1978 Thomas Kelly, P.S. 24599 set corner "using existing evidence, single proportionate measurements" and County Surveyor notes and filed L.C.R.C. in Liber 1, Page 343 of the Chippewa County Corner Records. Corner was apparently set in centerline of 14 Mile Road and on the extension of fence to North.

B. Description of corner evidence found and/or method applied in restoring or reestablishing corner:

(B-5) 1/4 Corner Common to Sections 7 and 18, T.45 N., R.1 E.

This corner is being re-established as part of the Chippewa County Remonumentation Program.

Found 1/2" iron pin in centerline of 14 Mile Road, on extension of fence to North and 1 foot East of fence to South. Distances East and West match Kelly survey. Accepted corner position as found and established four new witnesses.




C. Description of monument for corner and accessories established to perpetuate locating the position of the corner:

(B-5) 1/4 Corner Common to Sections 7 and 18, T.45 N., R.1 E.

Corner is a 1/2" iron pin in centerline of 14 Mile Road.

Witnesses:	Utility Pole	N82°E	203.98'
	8" White Spruce	N73°W	117.27'
	4" White Spruce	S56°E	107.44'
	Corner fence post	S04°W	31.30'
	10" Aspen	S75°W	110.20'

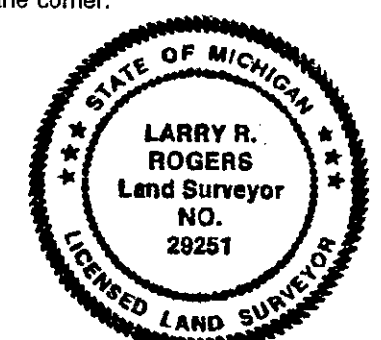

Signed by [Signature]

Date 19 DEC 1997

Surveyor's Michigan License No. 29251

NOTE: All bearings are compass bearings. All distances are to a nail in side of witness objects unless noted.

BOOK 10 PAGE 110