

SURVEY & REMONUMENTATION

APR 07 1998

**Chippewa County Remonumentation Corner
LAND CORNER RECORDATION CERTIFICATE
Filing Requirement of Act 74, Mich. P.A. 1970**

For corners in **SECTION**

<u>Chippewa</u>	Located In:	Corner Code #
1. Public Land Survey	T <u>45N</u> R <u>1E</u>	<u>C-4</u>
	T _____ R _____	
	T _____ R _____	
	T _____ R _____	
2. Property Controlling in Section	S _____ T _____ R _____	
	S _____ T _____ R _____	
3. Miscellaneous Property in Sec.	S _____ T _____ R _____	
	S _____ T _____ R _____	

\$7.00 LAND CORNER
\$2.00 MSSR
14 Jan 1998 3:20:34 PM Receipt #5566
RECEIVED FOR RECORD
CHIPPEWA COUNTY - STATE OF MICHIGAN
SHARON H. KENNEDY, REGISTER OF DEEDS
BOOK 10 PAGE 113
Register of Deeds Stamp & File Number

- 4. Lot No. _____, Recorded Plat _____
- 5. Private Claims _____

I, Larry R. Rogers, in a field survey on October 22, 1997, do hereby state that under requirements of P.A. 74, Michigan P.A. of 1970, the corner points mentioned in lines 1 and 2 above were in conformance with regulations and rules therefore as required in the current manual of survey instructions of the United States Department of the Interior, Bureau of Land Management or by a decree of a Court of Law and/or that the corner points mentioned in lines 3, 4 and 5 above were in conformance with the rules of the Michigan Board of Land Surveyors or by a Decree of a Court of Law; established, re-established, monumented, recovered, found as expressed below:

1	A	B	C	D	E	F	G	H	I	J	K	L	M
2		6		5		4		3		2	1		
3													
4		7	●	8		9		10	11				
5													
6		18		17		16		15		14			
7													
8		19		20		21		22		23			
9													
10		30		29		28		27		26			
11													
12		31		32		33		34		35			
13													

NOTE: Not more than 2 corners, all in the same town and range, may be recorded on this certificate.

A. Description of original monument and accessories and/or subsequent restoration:

(C-4) 1/4 Corner Common to Sections 7 and 8, T.45 N., R.1 E.


Original corner post set in September, 1845 by James H. Mullett. 1898 County Surveyor records indicate corner was reset from original B.T. and distance to original Section corner to South was short (2600 feet). In September, 1990, Ronald Bischer, P.S. 22428, set 1/2" iron pin next to old Cedar stake at very old corner fence post with fences running North-South-East and West. Bischer filed L.C.R.C. in Liber 7, Page 247 of the Chippewa County Corner Records.

B. Description of corner evidence found and/or method applied in restoring or reestablishing corner:

(C-4) 1/4 Corner Common to Sections 7 and 8, T.45 N., R.1 E.

This corner is being re-established as part of the Chippewa County Remonumentation Program.

Found 1/2" iron pin with P.S. cap No. 22428, 1.5 feet North of old square stake. County Surveyor distance of 2600 feet to Section corner to South now measures 2598.2 feet. Accepted corner position as found and established new witnesses.

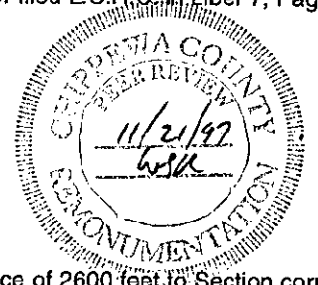


C. Description of monument for corner and accessories established to perpetuate locating the position of the corner:

(C-4) 1/4 Corner Common to Sections 7 and 8, T.45 N., R.1 E.

Corner is a 1/2" iron pin with P.S. cap No. 22428, 1.5 feet North of old square stake, with fences to North-South-East and West.

Witnesses:	8" White Pine	N12°E	19.48'
	12" Aspen	N31°W	16.13'
	8" Aspen	S48°E	27.87'
	4" Cedar	S31°W	36.74'

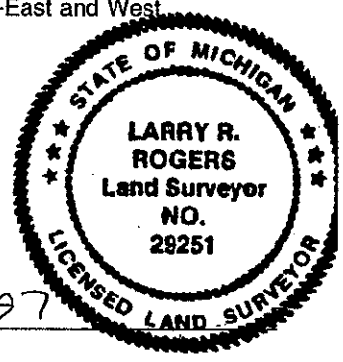

Signed by [Signature]

Date 19 DEC 1997

Surveyor's Michigan License No. 29251

NOTE: All bearings are compass bearings. All distances are to a nail in side of witness objects unless noted.