

APR 07 1998

Chippewa County Remonumentation Corner
LAND CORNER RECORDATION CERTIFICATE

Filing Requirement of Act 74, Mich. P.A. 1970 \$7.00 LAND CORNER
\$2.00 MSSR

14 Jan 1998 3:21:33 PM Receipt #5566
RECEIVED FOR RECORD
CHIPPEWA COUNTY - STATE OF MICHIGAN
SHARON H. KENNEDY, REGISTER OF DEEDS

BOOK 10 PAGE 114

Register of Deeds Stamp & File Number


SECTION
For corners in

Chippewa	Located In:	Corner Code #
1. Public Land Survey	T <u>45N</u> R <u>1E</u>	<u>C-5</u>
	T ___ R ___	
	T ___ R ___	
	T ___ R ___	
2. Property Controlling in Section	S ___ T ___ R ___	
	S ___ T ___ R ___	
3. Miscellaneous Property in Sec.	S ___ T ___ R ___	
	S ___ T ___ R ___	

4. Lot No. _____, Recorded Plat _____
5. Private Claims _____

I, Larry R. Rogers, in a field survey on October 22, 1997, do hereby state that under requirements of P.A. 74, Michigan P.A. of 1970, the corner points mentioned in lines 1 and 2 above were in conformance with regulations and rules therefore as required in the current manual of survey instructions of the United States Department of the Interior, Bureau of Land Management or by a decree of a Court of Law and/or that the corner points mentioned in lines 3, 4 and 5 above were in conformance with the rules of the Michigan Board of Land Surveyors or by a Decree of a Court of Law; established, re-established, monumented, recovered, found as expressed below:

NOTE: Not more than 2 corners, all in the same town and range, may be recorded on this certificate.

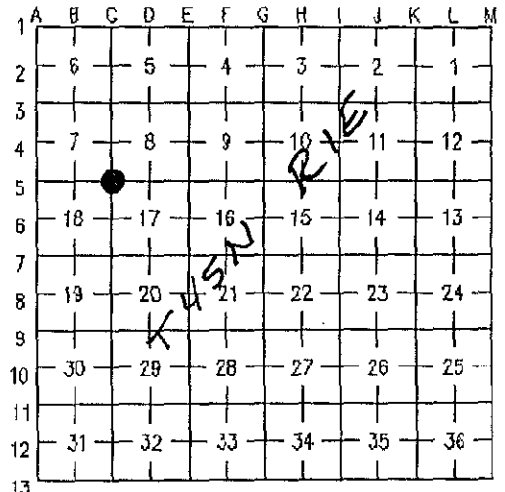

A. Description of original monument and accessories and/or subsequent restoration:

(C-5) Corner Common to Sections 7, 8, 17 and 18, T.45 N., R.1 E.


Original corner post was placed in September, 1845 by James H. Mullett. Chippewa County Surveyor Office "Corner Ties" book indicates a concrete monument at corner and Northeast corner of Big Rock, Southwest 50 feet. MDOT Surveyor, John Smallwood found an "iron sled runner shoe" at corner, established 3 witnesses and filed L.C.R.C. in Liber 2, Page 244 of Chippewa County Corner Records. In December, 1978 Thomas Kelly, P.S. 24599, recovered old concrete monument that matched previous Smallwood witnesses and filed L.C.R.C. in Liber 4, Page 69. In September, 1990 Ronald Bischer recovered concrete monument that checked with several previous witnesses and filed L.C.R.C. in Liber 7, Page 247.

B. Description of corner evidence found and/or method applied in restoring or reestablishing corner:

(C-5) Corner Common to Section 7, 8, 17 and 18, T.45 N., R.1 E.

This corner is being re-established as part of the Chippewa County Remonumentation Program.

Found old 4" concrete monument 3" below grade, 6.5' West of centerline of Seymour Road and 6.0' South of centerline of 14 Mile Road. Corner checks with tie to "Big Rock" to Southwest and several of Kelly/Bischer witnesses. Accepted position of monument as found.

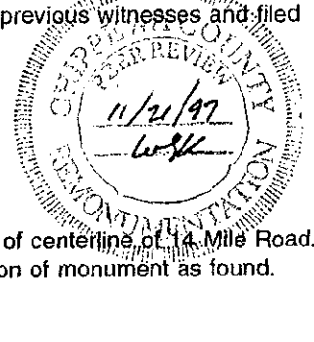

C. Description of monument for corner and accessories established to perpetuate locating the position of the corner:

(C-5) Corner Common to Sections 7, 8, 17 and 18, T.45 N., R.1 E.

Corner is 4" concrete monument 3" below grade, 6.5' West of centerline of Seymour Road and 6.0' South of centerline of 14 Mile Road.

Witnesses:	Utility Pole	N41°W	36.08'
	20" Spruce	N40°E	51.06'
	10" Spruce	S61°E	43.67'
	8" Spruce	S76°W	73.20'



Signed by [Signature]

Date 19 DEC 1997

Surveyor's Michigan License No. 29251

NOTE: All bearings are compass bearings. All distances are to a nail in side of witness objects unless noted.