

SURVEY & REMONUMENTATION

APR 07 1998

Chippewa County Remonumentation Corner
LAND CORNER RECORDATION CERTIFICATE
Filing Requirement of Act 74, Mich. P.A. 1970

For corners in

SECTION

<u>Chippewa</u>	Located In:	Corner Code #	
1. Public Land Survey	T <u>45N</u> R <u>1E</u>	<u>C-6</u>	
	T _____ R _____		
	T _____ R _____		
	T _____ R _____		
2. Property Controlling in Section	S _____ T _____ R _____		
	S _____ T _____ R _____		
3. Miscellaneous Property in Sec.	S _____ T _____ R _____		
	S _____ T _____ R _____		
4. Lot No. _____, Recorded Plat _____			
5. Private Claims _____			

\$7.00 LAND CORNER
\$2.00 N SSR
14 Jan 1998 3:22:19 PM Receipt #5566
RECEIVED FOR RECORD
CHIPPEWA COUNTY - STATE OF MICHIGAN
SHARON H. KENNEDY, REGISTER OF DEEDS

BOOK 10 PAGE 115

Register of Deeds Stamp & File Number

1	A	B	C	D	E	F	G	H	I	J	K	L	M
2		6	5		4		3		2	1			
3													
4		7	8		9		10		11	12			
5													
6		18	17		16		15		14	13			
7													
8		19	20		21		22		23	24			
9													
10		30	29		28		27		26	25			
11													
12		31	32		33		34		35	36			
13													

I, Larry R. Rogers, in a field survey on October 22, 1997, do hereby state that under requirements of P.A. 74, Michigan P.A. of 1970, the corner points mentioned in lines 1 and 2 above were in conformance with regulations and rules therefore as required in the current manual of survey instructions of the United States Department of the Interior, Bureau of Land Management or by a decree of a Court of Law and/or that the corner points mentioned in lines 3, 4 and 5 above were in conformance with the rules of the Michigan Board of Land Surveyors or by a Decree of a Court of Law; established, re-established, monumented, recovered, found as expressed below:

NOTE: Not more than 2 corners, all in the same town and range, may be recorded on this certificate.

A. Description of original monument and accessories and/or subsequent restoration:

(C-6) 1/4 Corner Common to Sections 17 and 18, T.45 N., R.1 E.

Original corner post was placed in September, 1845 by James H. Mullett. County Surveyor Brown found original post in 1898 and recorded distances of 2666 feet to North and 2805 feet to South. In December, 1978 Thomas Kelly found no corner, reestablished position using "proportionate distances on East line of Section to those distances called by Brown's notes", and filed L.C.R.C. in Liber 4, Page 69 of the Chippewa County Corner Records.

B. Description of corner evidence found and/or method applied in restoring or reestablishing corner:

(C-6) 1/4 Corner Common to Sections 17 and 18, T.45 N., R.1 E.

This corner is being re-established as part of the Chippewa County Remonumentation Program.


Found 1/2" iron pin in centerline of Seymour Road and on the extension of a fence line to East. Distances to corners North and South match Kelly's survey. Accepted corner position as found and established new witnesses.

C. Description of monument for corner and accessories established to perpetuate locating the position of the corner:

(C-6) 1/4 Corner Common to Sections 17 and 18, T.45 N., R.1 E.

Corner is a 1/2" iron pin in centerline of Seymour Road and on the extension of a fence line to East.

Witnesses:	6" White Spruce	N26°E	66.06'
	Corner fence post	S89°E	30.95'
	4" White Spruce	S71°W	53.97'
	Fence post	N88°W	30.08'

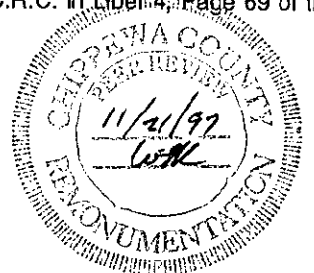

Signed by [Signature] Date 19 DEC 1997

Surveyor's Michigan License No. 29251

NOTE: All bearings are compass bearings. All distances are to a nail in side of witness objects unless noted.