

SURVEY & REMONUMENTATION

PR 11/21/97

APR 07 1998

SECTION

**Chippewa County Remonumentation Corner
LAND CORNER RECORDATION CERTIFICATE
Filing Requirement of Act 74, Mich. P.A. 1970**

For corners in

Chippewa

Located In:

Corner Code #

1. Public Land Survey

T 45N R 1E

D-3

T ___ R ___

T ___ R ___

T ___ R ___

2. Property Controlling in Section

S ___ T ___ R ___

S ___ T ___ R ___

3. Miscellaneous Property in Sec.

S ___ T ___ R ___

S ___ T ___ R ___

4. Lot No. _____, Recorded Plat _____

5. Private Claims _____

\$7.00 LAND CORNER

\$2.00 MSSR

14 Jan 1998 3:26:07 PM Receipt #5561

RECEIVED FOR RECORD

CHIPPEWA COUNTY - STATE OF MICHIGAN
SHARON H. KENNEDY, REGISTER OF DEEDS

BOOK **10** PAGE **116**

Register of Deeds Stamp & File Number

I, Larry R. Rogers, in a field survey on October 22, 1997, do hereby state that under requirements of P.A. 74, Michigan P.A. of 1970, the corner points mentioned in lines 1 and 2 above were in conformance with regulations and rules therefore as required in the current manual of survey instructions of the United States Department of the Interior, Bureau of Land Management or by a decree of a Court of Law and/or that the corner points mentioned in lines 3, 4 and 5 above were in conformance with the rules of the Michigan Board of Land Surveyors or by a Decree of a Court of Law; established, re-established, monumented, recovered, found as expressed below:

NOTE: Not more than 2 corners, all in the same town and range, may be recorded on this certificate.

1	A	B	C	D	E	F	G	H	I	J	K	L	M
2		6		5		4		3		2		1	
3				●				10		11		12	
4		7		8		9		10		11		12	
5													
6		18		17		16		15		14		13	
7													
8		19		20		21		22		23		24	
9													
10		30		29		28		27		26		25	
11													
12		31		32		33		34		35		36	
13													

A. Description of original monument and accessories and/or subsequent restoration:

(D-3) 1/4 Corner Common to Sections 5 and 8, T.45 N., R.1 E.

Original corner post was placed in September, 1845 by James H. Mullett. In 1897, County Surveyor Brown restored corner from original bearing trees. In September, 1990 Ronald Bischer, P.S. 22428 found no evidence of original corner position, reestablished corner midway and on line between Section corners to East and West, and filed L.C.R.C. in Liber 7, Page 246 of the Chippewa County Corner Records. Distances to corners East and West are 146 feet short of G.L.O. distances.

B. Description of corner evidence found and/or method applied in restoring or reestablishing corner:

(D-3) 1/4 Corner Common to Sections 5 and 8, T.45 N., R.1 E.

This corner is being re-established as part of the Chippewa County Remonumentation Program.



Found 1/2" iron pin with cap No. 22428 in small clump of evergreen trees, just South of old garbage pile. Distance to Southeast corner of Section 5 is 2487.18 feet and distance to Southwest corner of Section 5 is 2486.94 feet. Accepted corner position as found.

C. Description of monument for corner and accessories established to perpetuate locating the position of the corner:

(D-3) 1/4 Corner Common to Sections 5 and 8, T.45 N., R.1 E.

Corner is a 1/2" iron pin with cap No. 22428.

Witnesses: 14" White Spruce N25°W 15.14'
8" Aspen N76°E 3.59'
12" White Spruce S14°E 32.39'
8" White Birch S34°W 25.05'

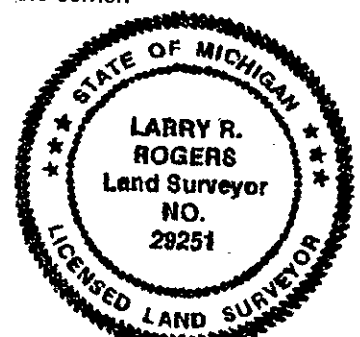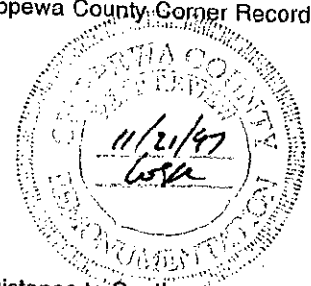

Signed by _____

Date 19 Dec 1997

Surveyor's Michigan License No. 29251

NOTE: All bearings are compass bearings. All distances are to a nail in side of witness objects unless noted.