

# SURVEY & REMONUMENTATION

**APR 07 1998**

Chippewa County Remonumentation Corner  
**LAND CORNER RECORDATION CERTIFICATE**  
Filing Requirement of Act 74, Mich. P.A. 1970

**SECTION**

For corners in

<u>Chippewa</u>	Located In:	Corner Code #	
1. Public Land Survey	T <u>45N</u> R <u>1E</u>	<u>E-2</u>	
	T ___ R ___		
	T ___ R ___		
	T ___ R ___		
2. Property Controlling in Section	S ___ T ___ R ___		
	S ___ T ___ R ___		
3. Miscellaneous Property in Sec.	S ___ T ___ R ___		
	S ___ T ___ R ___		
4. Lot No. _____, Recorded Plat _____			
5. Private Claims _____			

\$7.00 LAND CORNER  
\$2.00 MSSR  
14 Jan 1998 3:27:36 PM Receipt #3566  
RECEIVED FOR RECORD  
CHIPPewa COUNTY - STATE OF MICHIGAN  
SHARON H. KENNEDY, REGISTER OF DEEDS

**BOOK 10 PAGE 118**

**Register of Deeds Stamp & File Number**

I, Larry R. Rogers, in a field survey on October 22, 1997, do hereby state that under requirements of P.A. 74, Michigan P.A. of 1970, the corner points mentioned in lines 1 and 2 above were in conformance with regulations and rules therefore as required in the current manual of survey instructions of the United States Department of the Interior, Bureau of Land Management or by a decree of a Court of Law and/or that the corner points mentioned in lines 3, 4 and 5 above were in conformance with the rules of the Michigan Board of Land Surveyors or by a Decree of a Court of Law; established, re-established, monumented, recovered, found as expressed below:

**NOTE: Not more than 2 corners, all in the same town and range, may be recorded on this certificate.**

1	A	B	C	D	E	F	G	H	I	J	K	L	M
2		6		5	●	4		3		2		1	
3													
4		7		8		9		10		11		12	
5													
6		18		17		16		15		14		13	
7													
8		19		20		21		22		23		24	
9													
10		30		29		28		27		26		25	
11													
12		31		32		33		34		35		36	
13													

A. Description of original monument and accessories and/or subsequent restoration:

(E-2) 1/4 Corner Common to Sections 4 and 5, T.45 N., R.1 E.

Original corner post was set September, 1845 by James H. Mullett. In a September, 1983 survey by Larry R. Rogers, no evidence of original corner position was found. A 1/2" bent iron pin was found in North-South gravel road (Shunk Road) 1', more or less, South of the extension of fenceline to West. Corner position accepted as found, bent iron was replaced with new 1/2" iron pin, witnesses established and corner filed in Liber 6, Page 285 of the Chippewa County Corner Records. Corner was subsequently used in survey by Lawrence Weinreis dated September 23, 1991 and Ronald Bischer dated September 25, 1996.

B. Description of corner evidence found and/or method applied in restoring or reestablishing corner:


(E-2) 1/4 Corner Common to Sections 4 and 5, T.45 N., R.1 E.  
This corner is being re-established as part of the Chippewa County Remonumentation Program.

Recovered 1/2" iron pin and witnesses as previously recorded. Accepted corner position as found and established four new witnesses. As per 1919 County Surveyor notes "there is quite an angle" at the West 1/4 corner of Section 4. The 1/4 corner is 228.4' West of a straight line between the Northwest and Southwest corners of Section 4.

C. Description of monument for corner and accessories established to perpetuate locating the position of the corner:

(E-2) 1/4 Corner Common to Sections 4 and 5, T.45 N., R.1 E.  
Corner is a 1/2" x 24" iron pin 2.5' East of West edge of North-South gravel road (Shunk Road).

Witnesses:	12" W. Spruce	N23°E	172.19'
	4" W. Spruce	N09°W	64.24'
	4" Aspen	S80°W	31.64'
	4" W. Spruce	S29°W	51.93'
	Utility Pole	N12°E	183.61'

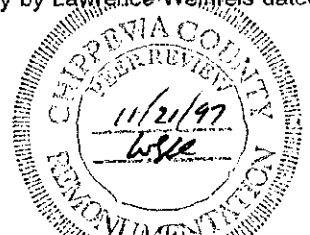

Signed by [Signature] Date 19 DEC 1997

Surveyor's Michigan License No. 29251  
**NOTE: All bearings are compass bearings. All distances are to a nail in side of witness objects unless noted.**