

# SURVEY & REMONUMENTATION

APR 07 1998

Chippewa County Remonumentation Corner  
**LAND CORNER RECORDATION CERTIFICATE**  
Filing Requirement of Act 74, Mich. P.A. 1970

SECTION

For corners in

Chippewa	Located In:	Corner Code #	
1. Public Land Survey	T <u>45N</u> R <u>1E</u>	<u>E-5</u>	
	T ___ R ___		
	T ___ R ___		
	T ___ R ___		
2. Property Controlling in Section	S ___ T ___ R ___		
	S ___ T ___ R ___		
3. Miscellaneous Property in Sec.	S ___ T ___ R ___		
	S ___ T ___ R ___		

\$7.00 LAND CORNER  
\$2.00 MSSR  
14 Jan 1998 3:34:09 PM Receipt #5561  
RECEIVED FOR RECORD  
CHIPPEWA COUNTY - STATE OF MICHIGAN  
SHARON H. KENNEDY, REGISTER OF DEEDS


BOOK **10** PAGE **121**

Register of Deeds Stamp & File Number

4. Lot No. \_\_\_\_\_, Recorded Plat \_\_\_\_\_  
5. Private Claims \_\_\_\_\_

I, Larry R. Rogers, in a field survey on October 22, 1997, do hereby state that under requirements of P.A. 74, Michigan P.A. of 1970, the corner points mentioned in lines 1 and 2 above were in conformance with regulations and rules therefore as required in the current manual of survey instructions of the United States Department of the Interior, Bureau of Land Management or by a decree of a Court of Law and/or that the corner points mentioned in lines 3, 4 and 5 above were in conformance with the rules of the Michigan Board of Land Surveyors or by a Decree of a Court of Law; established, re-established, monumented, recovered, found as expressed below:


**NOTE: Not more than 2 corners, all in the same town and range, may be recorded on this certificate.**

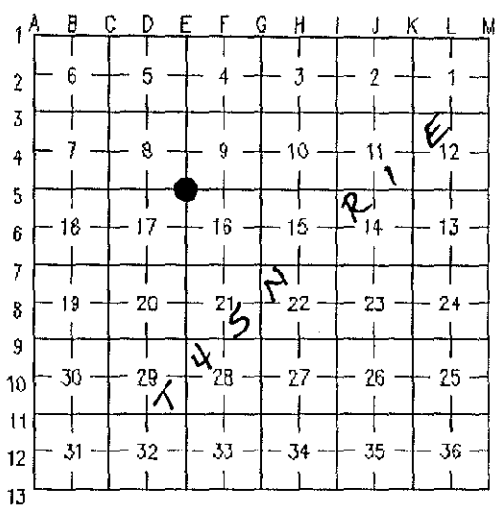

A. Description of original monument and accessories and/or subsequent restoration:

(E-5) Corner Common to Sections 8, 9, 16 and 17, T.45 N., R.1 E.

Original corner post was placed in September, 1845 by James H. Mullett with 20" Cedar B.T. N32°W 35 links (23.1 feet). County Surveyor "Corner Ties" book indicates "large Cedar post 6" butt, large end up" and a cement monument with a 12" W. Birch B.T. S75°E 23 feet. In September, 1990 Ronald Bischof, P.S. 22428, found concrete monument, 1" iron pipe (placed by landowner), and recovered an original B.T. stump N32°W 23.3 feet.

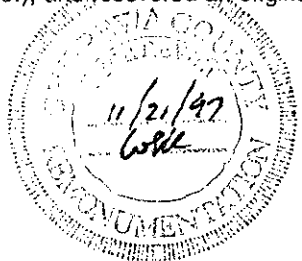

B. Description of corner evidence found and/or method applied in restoring or reestablishing corner:

(E-5) Corner Common to Sections 8, 9, 16 and 17, T.45 N., R.1 E.

This corner is being re-established as part of the Chippewa County Remonumentation Program.

Found iron pipe next to old concrete monument and remains of original B.T. stump to Northwest. Corner now falls in manmade fish rearing pond and is under water for about six months each year. Pond is drained every fall for removal of fish. The pond is quite large and nearby witnesses are not available.

C. Description of monument for corner and accessories established to perpetuate locating the position of the corner:

(E-5) Corner Common to Sections 8, 9, 16 and 17, T.45 N., R.1 E.

Corner is and old concrete monument in drained fish rearing pond.

Witnesses:	B.T. stump	N32°W	23.3'
	Steel fence post	North	2.0'
	1" iron pipe (4' high)	South	2.0'
	East 1/4 Corner Section 8	N03°33' 06"W	2637.88'
	South 1/4 Corner Section 9	N87°26' 28"E	2650.90'
	West 1/4 Corner Section 16	S01°41' 14"E	2673.72'
	North 1/4 Corner Section 17	N83°38' 57"W	2647.77'



Signed by [Signature] Date 19 Dec 1997

Surveyor's Michigan License No. 29251

**NOTE: All bearings are compass bearings. All distances are to a nail in side of witness objects unless noted.**