

RECORDED

MAR 09 1994

CHIPPEWA COUNTY REMONUMENTATION CORNER

RECEIVED FOR RECORD
CHIPPEWA COUNTY
STATE OF MICHIGAN

LAND CORNER RECORDATION CERTIFICATE
Filing Requirement of Act 74, Mich. P.A. 1970

93 DEC 30 PM 2:43

COMMISSION

For corners in

Chippewa
(County)

Located In:

Corner Code #

- 1. Public Land Survey
T45N R 1E H-1 Same
T46N R 1E H-13 Corner
T R
T R
- 2. Property Controlling
S T R
S T R
- 3. Miscellaneous
S T R
S T R

J. Roger Matlock
REGISTER OF DEEDS

Register of Deeds Stamp & File Number

- 4. Lot No. _____, Recorded Plat _____
- 5. Private Claims _____


A	B	C	D	E	F	G	H	I	J	K	L	M
2	6	5	4	3	2	1						
3												
4	7	8	9	10	11	12						
5												
6	18	17	16	15	14	13						
7												
8	19	20	21	22	23	24						
9												
10	30	29	28	27	26	25						
11												
12	31	32	33	34	35	36						
13												

I, Keith R. Waters in a field survey on December 2, 19 93, do hereby certify that under requirements of P.A. 74, Michigan P.A. of 1970, the corner points mentioned in lines 1 and 2 above were in conformance with regulations and rules therefore as required in the current manual of survey instructions of the United States Department of the Interior, Bureau of Land Management or by a decree of a Court of Law and/or that the corner points mentioned in lines 3, 4 and 5 above were in conformance with the rules of the Michigan Board of Land Surveyors or by a Decree of a Court of Law; established, re-established, monumented, re-monumented, recovered, found as expressed below:

NOTE: Not more than 4 corners, all in the same town and range, may be recorded on this certificate.


A. Description of original monument and accessories and/or subsequent restoration:

H-1 (T45N, R1E)
1/4 Corner Common to Section 3, T45N, R1E & Section 34, T46N, R1E.
Original ties to post: Birch 8, N12°W 38 links
Birch 10, N48°W 52 links

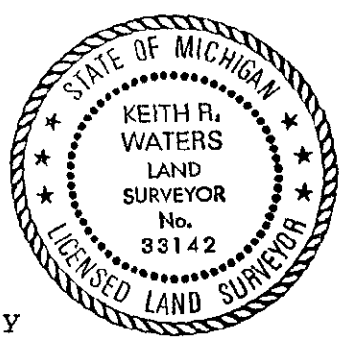

B. Description of corner evidence found and/or method applied in restoring or reestablishing corner:

H-1 (T45N, R1E)
This corner is being perpetuated as part of the Chippewa County Remonumentation Program.
Found a 1/2" iron pin with cap #29251 (Larry R. Rogers) 1 foot north of the south edge of east-west asphalt road (12 Mile Road), approximately 7 feet west of the centerline of gravel road to the south (Lechner Road). Corner is on line between section corners 2639.33 feet west and 2639.28 feet east. Distance to section corner east is shown as 2638 feet in old County Surveyor notes. Accepted corner as found and established witness objects.

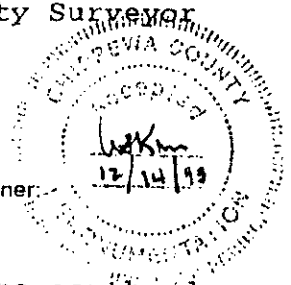

C. Description of monument for corner and accessories established to perpetuate locating the position of the corner:

H-1 (T45N, R1E)
Corner is a 1/2" iron pin with plastic cap #29251 1 foot north of the south edge of pavement on 12 Mile Road, 7 feet west of the centerline of Lechner Road to the south. Witnesses:
Power Pole, S38°E 58.08'
Power Pole, N42°E 72.48'
Fence Post, N09°W 58.14'
Center of Michigan Bell Sign Post, S47°W 52.93'
Note: Unless noted otherwise, distances are to a nail and tag in the side of the witness object. Bearings are compass bearings corrected for declination.

Signed by Keith R. Waters Date 12-30-93
Surveyor's Michigan License No. 33142