

SURVEY & REMONUMENTATION

NOV 07 1994

COMMISSION

Chippewa County Remonumentation Corner

LAND CORNER RECORDATION CERTIFICATE

Filing Requirement of Act 74, Mich. P.A. 1970 \$ 7.00

LAND CORNER

\$ 2.00 MSSR

18 OCT 94 1:03 P.M. RECEIPT# 700

RECEIVED FOR RECORD

CHIPPEWA COUNTY - STATE OF MICHIGAN

SHARON H. KENNEDY, REGISTER OF DEEDS

For corners in

Chippewa

(County)

Located In:

Corner Code #

- 1. Public Land Survey T 45N R 1E H-13
T _____ R _____
T _____ R _____
T _____ R _____
- 2. Property Controlling S _____ T _____ R _____
in Section S _____ T _____ R _____
- 3. Miscellaneous S _____ T _____ R _____
Property in Sec. S _____ T _____ R _____
- 4. Lot No. _____, Recorded Plat _____
- 5. Private Claims _____

Register of Deeds Stamp & File Number

	A	B	C	D	E	F	G	H	I	J	K	L	M
2	6	5	4	3	2	1							
3													
4	7	8	9	10	11	12							
5													
6	18	17	16	15	14	13							
7													
8	19	20	21	22	23	24							
9													
10	30	29	28	27	26	25							
11													
12	31	32	33	34	35	36							
13													

I, William L. Karr, in a field survey on December 7, 19 93, do hereby certify that under requirements of P.A. 74, Michigan P.A. of 1970, the corner points mentioned in lines 1 and 2 above were in conformance with regulations and rules therefore as required in the current manual of survey instructions of the United States Department of the Interior, Bureau of Land Management or by a decree of a Court of Law and/or that the corner points mentioned in lines 3, 4 and 5 above were in conformance with the rules of the Michigan Board of Land Surveyors or by a Decree of a Court of Law; established, re-established, monumented, re-monumented, recovered, found as expressed below:

NOTE: Not more than 4 corners, all in the same town and range, may be recorded on this certificate.

A. Description of original monument and accessories and/or subsequent restoration:

(H-13) South 1/4 Corner of Section 34 (T45N-R1E)

1845: J.H. Mullett, Set 1/4 Section post.
12" Fir N57°E 13 links
6" Fir N05°W 22 links

B. Description of corner evidence found and/or method applied in restoring or reestablishing corner:



(H-13) This corner is being re-established as part of the Chippewa County Remonumentation Program.

Found no evidence of original corner. Corner re-established midway and on line between the Southeast and Southwest corners of Section 34. Corner falls on old fence line to the North.

C. Description of monument for corner and accessories established to perpetuate locating the position of the corner:

(H-13) Corner is a 3/4" x 24" iron with plastic "Chippewa County Remonumentation" cap. Corner falls in the centerline of Eighteen Mile Road. Falls 492' West of the centerline of a North-South creek on the approximate range of fence to the North and 10.5' East of fence to the South.

Witnesses: 22" Oak N60°E 374.51'
North 1/4 Corner of Section 3 East 20.53'
Southwest Corner Metal Building S67°E 241.67'
Power Pole S14°W 40.87'

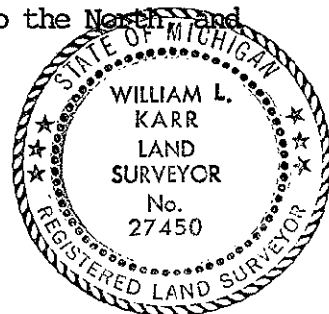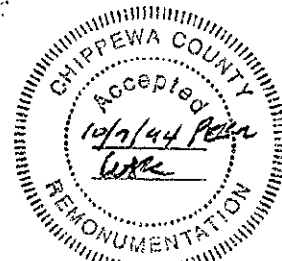

Signed by William L. Karr Date 1/20/94

Surveyor's Michigan License No. 27450

NOTE: Bearings are compass bearings corrected for declination.

Distances are to a nail in side of witness objects unless noted.