

MAR 09 1994

COMMISSION

Chippewa County Remonumentation Corner

RECEIVED FOR RECORD
CHIPPEWA COUNTY
STATE OF MICHIGAN

LAND CORNER RECORDATION CERTIFICATE
Filing Requirement of Act 74, Mich. P.A. 1970

93 DEC 29 AM 10:27

For corners in

Chippewa

(County)

Located In:

Corner Code #

1. Public Land Survey

T 45N R 1E

I-3

T R

T R

T R

2. Property Controlling in Section

S T R

S T R

3. Miscellaneous

S T R

Property in Sec.


S T R

J. Roger Malott
REGISTER OF DEEDS

Register of Deeds Stamp & File Number

4. Lot No. _____, Recorded Plat _____

5. Private Claims _____

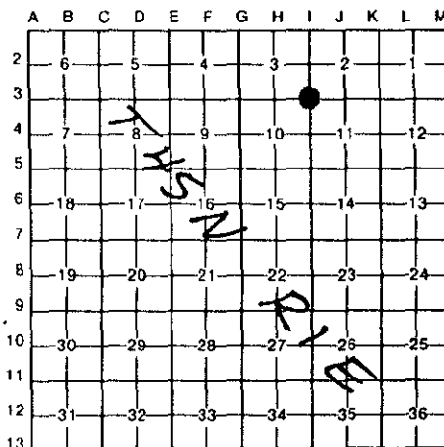

I, Larry R. Rogers, in a field survey on November 11, 1993

do hereby certify that under requirements of P.A. 74, Michigan P.A. of 1970, the corner points mentioned in lines 1 and 2 above were in conformance with regulations and rules therefore as required in the current manual of survey instructions of the United States Department of the Interior, Bureau of Land Management or by a decree of a Court of Law and/or that the corner points mentioned in lines 3, 4 and 5 above were in conformance with the rules of the Michigan Board of Land Surveyors or by a Decree of a Court of Law; established, re-established, monumented, re-monumented, recovered, found as expressed below:

NOTE: Not more than 4 corners, all in the same town and range, may be recorded on this certificate.

A. Description of original monument and accessories and/or subsequent restoration:

(I-3) Section Corner Common to Sections 2, 3, 10 & 11, T45N-R1E

This corner was previously recorded in 1986 by L.R. Rogers in Liber 6, Page 322 of the Chippewa County Corner Records as a 1 1/2" iron pipe with the following witnesses:

- Power Pole (cut off) N66°E 82.32'
- Corner Fence Post S48°E 64.11'
- Power Pole (DR1/76/87) S48°W 56.99'

B. Description of corner evidence found and/or method applied in restoring or reestablishing corner:

(I-3) This corner is being perpetuated as part of the Chippewa County Remonumentation Program.

Corner was removed by the Chippewa County Road Commission during reconstruction of Riverside Drive and replaced with a monument box. Found mangled pipe in monument box - replaced with 3/4" x 24" iron pin. Position checks with three witnesses from the 1986 record. Accepted position and established one new witness.

W.R.K.
11/30/93

C. Description of monument for corner and accessories established, to perpetuate locating the position of the corner:

(I-3) This corner is a 3/4" iron pin with plastic remonumentation cap in monument box in centerline of Riverside Drive and Thirteen Mile Road.

- Witnesses: "V" cut in North end of 20" C.M.P. N60°W 43.22'
- Cut off Utility Pole N66°E 82.33'
- Corner Fence Post S48°E 64.39'
- Utility Pole (DR1/76/87) S48°W 56.99'



Signed by [Signature]

Date 30 Nov 1993

Surveyor's Michigan License No. 29251

NOTE: Bearings are compass bearings corrected for declination.
Distances are to a nail in side of witness objects unless noted.