

LAND CORNER RECORDATION CERTIFICATE  
Filing Requirement of Act 74, Mich. P.A. 1970

For corners in  
Chippewa  
(County)

	Located In:	Corner Code #
1. Public Land Survey	T <u>45N</u> R <u>1E</u>	<u>I-8</u>
	T _____ R _____	_____
	T _____ R _____	_____
	T _____ R _____	_____
2. Property Controlling in Section	S _____ T _____ R _____	_____
	S _____ T _____ R _____	_____
3. Miscellaneous Property in Sec.	S _____ T _____ R _____	_____
	S _____ T _____ R _____	_____

RECEIVED FOR RECORD  
CHIPPEWA COUNTY  
STATE OF MICHIGAN


94 JUL 22 AM 11:15

*J. Roger Malott*

REGISTER OF DEEDS

Register of Deeds Stamp & File Number

4. Lot No. \_\_\_\_\_, Recorded Plat \_\_\_\_\_  
5. Private Claims \_\_\_\_\_

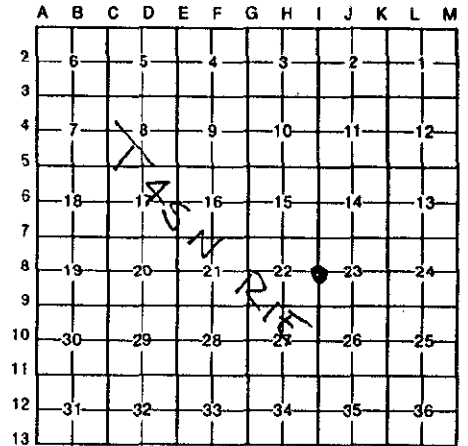

I, Larry R. Rogers, in a field survey on NOVEMBER 23, 19 93, do hereby certify that under requirements of P.A. 74, Michigan P.A. of 1970, the corner points mentioned in lines 1 and 2 above were in conformance with regulations and rules therefore as required in the current manual of survey instructions of the United States Department of the Interior, Bureau of Land Management or by a decree of a Court of Law and/or that the corner points mentioned in lines 3, 4 and 5 above were in conformance with the rules of the Michigan Board of Land Surveyors or by a Decree of a Court of Law; established, re-established, monumented, re-monumented, recovered, found as expressed below:

NOTE: Not more than 4 corners, all in the same town and range, may be recorded on this certificate.

A. Description of original monument and accessories and/or subsequent restoration:

(I-8) 1/2 Corner Common to Sections 22 & 23 (T45N-R1E)

1845:	J.H. Mullett set posts.	9" Hemlock	S85°E	16 links
		6" Cedar	N77°W	21 links
1992:	L.R. Rogers set 1/2" x 24" pin with cap #29251 (Liber 7, Page 400)			
Witnesses:	Utility Pole (DR2/190/7)		N68°W	50.19'
	6" Cedar		S55°W	79.51'
	18" Spruce		S21°E	121.49''
	Utility Pole (0336/402)		S62°E	48.68'
	1/2" Iron with Cap #29251		East	33.00'

B. Description of corner evidence found and/or method applied in restoring or reestablishing corner:

(I-8) Found corner and all accessories as recorded in Liber 4, Page 400 of Chippewa County Records. Accepted corner position as found.

SURVEY &  
REMONUMENTATION

JUL 26 1994

COMMISSION



C. Description of monument for corner and accessories established to perpetuate locating the position of the corner:

(I-8) Corner is a 1/2" x 24" iron with L.S. cap #29251 in pavement in the centerline of Riverside Drive.

Witnesses:	Utility Pole (DR2/190/7)	N68°W	50.19'
	6" Cedar	S55°W	79.51'
	18" Spruce	S21°E	121.49''
	Utility Pole (0336/402)	S62°E	48.68'
	1/2" Iron with Cap #29251	East	33.00'

Signed by [Signature] Date 20 July 1994

Surveyor's Michigan License No. 29251

NOTE: Bearings are compass bearings corrected for declination.

Distances are to a nail in side of witness objects unless noted.